

Wayne
J 40
8-69

MISSISSIPPI
BOARD OF WATER COMMISSIONERS
416 North State Street
Jackson, Mississippi 39201

CODED

WATER WELL DRILLERS LOG

June 1 1969 date well completed
Route Drilling firm name
Wayne county well located

LANDOWNER: Thomas
James Simmons
44 Mansfield Miss
(mailing address)

WELL LOCATION:
sec. 5 T 90 N R 6 E
7 miles N of Waynesboro
(distance) (direction) (nearest town)

WELL PURPOSE: Home
(home, irrigation, municipal, industrial)

- WELL COMPLETION DATA:
- (1) diameter (inches) 2"
 - (2) total depth (feet) 479
 - (3) static water level (feet) 16.6 below top of ground
 - (4) casing steel 44.5 (material) (depth)
2" if telescope see back.
 - (5) screen 24" 45.5 (length) (depth to top)
1 1/2" 20' in S.S. (size) (material)
 - (6) pump 1 hp 3 1/2 (HP) (yield gpm)
elec (type power)
 - (7) electric log no (yes or no)
 - (organization running log)
 - (8) how well bottom plugged


description of formations encountered	from	to
rest clay	0	10
rest chalk	10	35
blue chalk	35	52
crack rocks	52	66
white chalk	66	92
rock strata	92	111
blue chalk	111	202
crack rocks		202
blue chalk	202	225
rock soft rock	225	232
blue chalk	232	292
rock strata	292	310
fine sand	310	316
crack rocks	316	317
blue chalk	317	327
hard rock	327	328
chalk to sand	328	335
rock strata	335	352
hard green chalk	352	391
all rock	391	395
rock strata	395	405
hard sand	405	435
blue chalk	435	443
hard clean sand	443	479
about white shell		
the sand		
collected at 208'		

DRILLERS REMARKS:
17' 4" on to cut off
crack

REC-410
MISSISSIPPI WATER COMMISSION

If well telescopes please sketch and show depths.

GROUND LEVEL

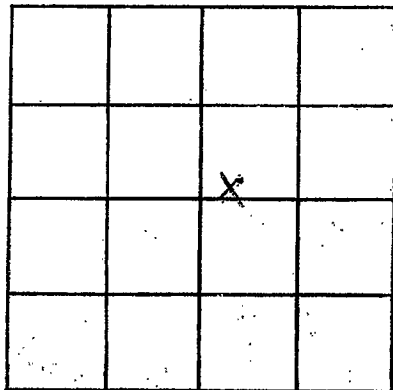

SECTION 5

Please indicate well location X.

ADDITIONAL INFORMATION

If more than one screen, show locations of each on sketch.