

Wayne  
 J 41  
 8-15-69

MISSISSIPPI  
 BOARD OF WATER COMMISSIONERS  
 416 North State Street  
 Jackson, Mississippi 39201

CODED


WATER WELL DRILLERS LOG

Aug 15 1969 date well completed  
 69 Dexter Drilling Co. firm name  
 Wayne county well located

LANDOWNER: Thomas Carl K. ...	description of formations encountered	from	to
12 Wagonwheel Mine (mailing address)	red clay ... chert	0	10 70 71
<b>WELL LOCATION:</b> sec 23 T 9 N R 6 E S W 3 1/2 miles N.E. of ... (distance) (direction) (nearest town)			
<b>WELL PURPOSE:</b> (home, irrigation, municipal, industrial)			
<b>WELL COMPLETION DATA:</b>			
(1) diameter (inches) 2"			
(2) total depth (feet) 68'			
(3) static water level (feet) 55' below top of ground.			
(4) casing 1 1/2" (material) 13' (depth)			
2" if telescope see back. (size)			
(5) screen 5' 1 1/2" (length) 15' (depth to top)			
1 1/2" 7.14 S.S. (size) (material)			
(6) pump 1 (HP) 8 (yield gpm)			
other (type power)			
(7) electric log no (yes or no)			
(organization running log)			
(8) how well bottom plugged			
<b>DRILLERS REMARKS:</b> SFD 17 ... ... ...			

If well telescopes please sketch and show depths.

GROUND LEVEL

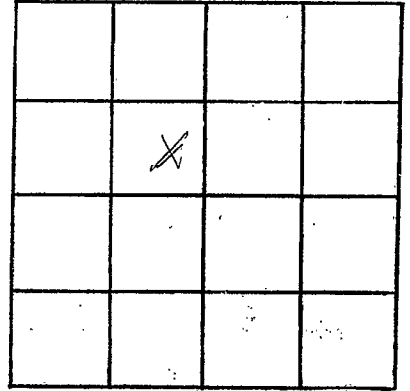

SECTION 33

Please indicate well location X.

ADDITIONAL INFORMATION

If more than one screen,  
show locations of each on sketch.