

WAYNE
 J 43
 1-15-70

MISSISSIPPI
 BOARD OF WATER COMMISSIONERS
 416 North State Street
 Jackson, Mississippi 39201

CODED

WATER WELL DRILLERS LOG

Jan 15 1970 Porter Drilling & Log Name
 date well completed firm name county well located


LANDOWNER: <u>Clinton Doby</u>	description of formations encountered	from	to
<u>212 Hammond Miss</u> (mailing address)	<u>red clay</u>	<u>0</u>	<u>10</u>
WELL LOCATION: sec <u>29</u> T <u>90</u> S R <u>6</u> E <u>3</u> miles <u>NE</u> of <u>Hammond</u> (distance) (direction) (nearest town)	<u>Chalk & s. sand</u>	<u>10</u>	<u>35</u>
WELL PURPOSE: <u>home</u> (home, irrigation, municipal, industrial)	<u>dry sand</u>	<u>35</u>	<u>60</u>
WELL COMPLETION DATA: (1) diameter (inches) <u>2"</u>	<u>Chalk</u>	<u>60</u>	<u>66</u>
(2) total depth (feet) <u>77'</u>	<u>sand & chalk</u>	<u>66</u>	<u>71</u>
(3) static water level (feet) <u>55</u> below top of ground	<u>lime sand</u>	<u>71</u>	<u>74</u>
(4) casing <u>steel</u> <u>71</u> (material) (depth)	<u>loose sand & chalk</u>	<u>74</u>	<u>77</u>
<u>2"</u> if telescope see back. (size)	<u>shale with</u>		
(5) screen <u>5'</u> <u>72</u> (length) (depth to top)	<u>shale in sand & chalk</u>		
<u>1 1/2"</u> <u>galv S.S.</u> (size) (material)			
(6) pump <u>1</u> <u>7</u> (HP) (yield gpm)			
<u>elec</u> (type power)			
(7) electric log <u>no</u> (yes or no)			
(organization running log)			
(8) how well bottom plugged <u>flush joint</u>			
DRILLERS REMARKS:			

FEB 6 1970

MISS. ST. OF
 GEOL. & NAT. RES.
 JACKSON, MISSISSIPPI

If well telescopes please sketch and show depths.

GROUND LEVEL

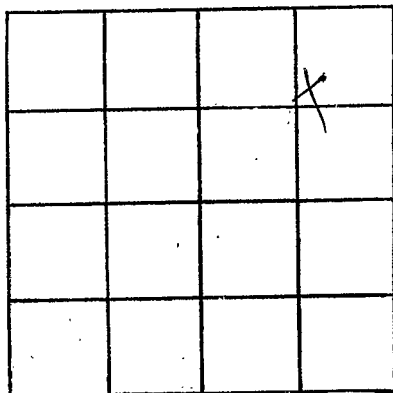

SECTION 29

Please indicate well location 'X'.

ADDITIONAL INFORMATION

If more than one screen,
show locations of each on sketch.