

WAYNE
 J 44
 1-17-70

MISSISSIPPI
 BOARD OF WATER COMMISSIONERS
 416 North State Street
 Jackson, Mississippi 39201

CODED

WATER WELL DRILLERS LOG

Jan 17 1970 Porte Drilling & Log Wayne
 date well completed firm name county well located

LANDOWNER: Eddy Sandy
At 2 Magnolia Miss
 (mailing address)

description of formations encountered	from	to
rest clay	0	10
chalk & sand	10	37
sand	37	67
stopped on chalk		

WELL LOCATION:
 sec 20 T 70 N R 6 E
3 miles NE of Thyngboro
 (distance) (direction) (nearest town)

5' 1 1/4" 7 slot S.S.

WELL PURPOSE: Home
 (home, irrigation, municipal, industrial)

with 3' 1/4" log best

WELL COMPLETION DATA:
 (1) diameter (inches) 2"
 (2) total depth (feet) 67'
 (3) static water level (feet) 26' below top of ground.
 (4) casing steel 63' (material) (depth)
2" (size) if telescope see back.
 (5) screen 5' 64' (length) (depth to top)
1 1/4" 7 slot S.S. (size) (material)
 (6) pump 3/4 8 (HP) (yield gpm)
elec (type power)
 (7) electric log no (yes or no)
 (organization running log)

in with packer
 42' 1 1/4" drop pipe


(8) how well bottom plugged
flush round
 DRILLERS REMARKS:

FEB 6 - 1970

MISS. BD. OF
 WATER COMMISSIONERS

If well telescopes please sketch and show depths.

GROUND LEVEL

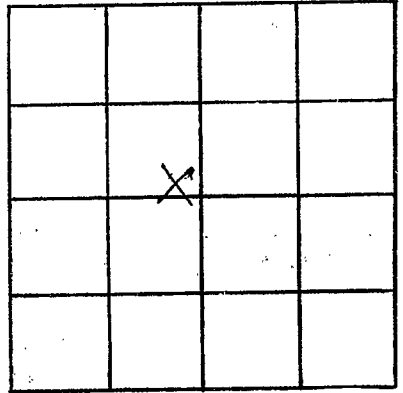

SECTION 29

Please indicate well location X.

ADDITIONAL INFORMATION

If more than one screen,
show locations of each on sketch.