

Wayne  
J 45  
4-14-70

MISSISSIPPI  
BOARD OF WATER COMMISSIONERS  
416 North State Street  
Jackson, Mississippi 39201

WATER WELL DRILLERS LOG

April 14 1970 Porter-Dillingham Wayne  
date well completed firm name county well located

LANDOWNER: James L. Brown

description of formations encountered	from	to
---------------------------------------	------	----

Atty Marynealor Miss  
(mailing address)

clay & chalk	0	25
rock	25	27
sand	27	33

WELL LOCATION:  
sec 30 T 9 N R 6 E 033  
3 miles N of 33  
(distance) (direction) (nearest town)

chalk	33	39
rock stratum	39	40
chalk	40	48
rock	48	49

WELL PURPOSE: Home  
(home, irrigation, municipal, industrial)

chalk	49	54
rock	54	56
chalk	56	59

WELL COMPLETION DATA:

rock	59	60
chalk	60	66

(1) diameter (inches) 2"

chalk & sand	66	72
--------------	----	----

(2) total depth (feet) 99'

real sand	72	89
sand & chalk	89	100

(3) static water level (feet) 84' below top of ground.

chalk	100	112
-------	-----	-----

(4) casing steel 93' (material) (depth)

lost circulation at 110'		
soft rock shale	112	127

2" if telescope see back. (size)

stop on hard rock		
-------------------	--	--

(5) screen 6" 93' (length) (depth to top)

6" 1/4" 60 ga S.S. but in with rather loose cement that bottom		
--	--	--

1 1/4" 60 ga S.S. (size) (material)

90' 1 1/4" drop pipe		
----------------------	--	--

(6) pump 1 1/2 (HP) 6 1/2 (yield gpm)

elec (type power)

(7) electric log no (yes or no)

(organization running log)

(8) how well bottom plugged plug ground


DRILLERS REMARKS:

MAY 8 1970

MISS. BD. OF WATER COMMISSIONERS

If well telescopes please sketch and show depths.

GROUND LEVEL

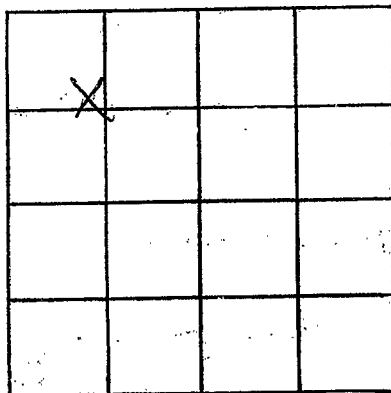

SECTION 30

Please indicate well location X.

ADDITIONAL INFORMATION

If more than one screen,  
show locations of each on sketch.