

Wayne
J 46
5-19-70

MISSISSIPPI
BOARD OF WATER COMMISSIONERS
416 North State Street
Jackson, Mississippi 39201

WATER WELL DRILLERS LOG


May 19 1970 Booth Drilling Co Wayne
date well completed firm name county well located

LANDOWNER: <u>Daniel Dumas</u>	description of formations encountered	from to
<u>At 1</u> <u>State Line</u> (mailing address) <u>033</u>	<u>Clay</u>	<u>0 12</u>
WELL LOCATION: sec <u>19</u> T <u>6</u> N R <u>6</u> <u>7</u> miles <u>SW</u> <u>Buchanan</u> (distance) (direction) of (nearest town)	<u>Blue chalk</u> <u>fine sand & chalk</u> <u>fine course sand & shells</u> <u>medium course sand</u> <u>medium sand</u> <u>part of silt & shell</u> <u>silt & fine sand</u>	<u>12 53</u> <u>53 65</u> <u>65 69</u> <u>69 75</u> <u>75 86</u>
WELL PURPOSE: <u>Home</u> (home, irrigation, municipal, industrial)		
WELL COMPLETION DATA: (1) diameter (inches) <u>2"</u> (2) total depth (feet) <u>86'</u> (3) static water level (feet) <u>54</u> (below/above top of ground) (4) casing <u>steel</u> <u>77'</u> (material) (depth) <u>2"</u> if telescope see back. (size) (5) screen <u>6"</u> <u>80'</u> (length) (depth to top) <u>1/2"</u> <u>Local S.S.</u> (size) (material) (6) pump <u>1</u> <u>12</u> (HP) (yield gpm) <u>elec</u> (type power) (7) electric log <u>no</u> (yes or no) (organization running log) (8) how well bottom plugged <u>flush ground</u>	<u>6' 1 1/4" 60 gal. sub well</u> <u>4' 1 1/4" log run test</u> <u>10 11 1/2</u> <u>is with pack</u> <u>65' 1 1/4" clay 42, 40</u> <u>11</u>	
DRILLERS REMARKS:		

MAY 29 1970
MISS. BD. OF
WATER COMM.

If well telescopes please sketch and show depths.

GROUND LEVEL

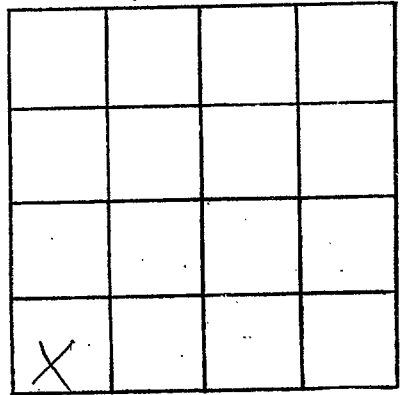

SECTION 19

Please indicate well location X.

ADDITIONAL INFORMATION

If more than one screen,
show locations of each on sketch.