

MISSISSIPPI  
BOARD OF WATER COMMISSIONERS  
416 North State Street  
Jackson, Mississippi 39201

**CODED**

MISS. BD. OF  
WATER COMM.

WATER WELL DRILLERS LOG

WAYNE  
J 48  
9-24-70


Sept. 24 1970 date well completed  
Dante Drilling & Log firm name  
Wagner county well located

| LANDOWNER: <u>O. J. Whigham</u>   | description of formations encountered | from                   | to                |
|---|---------------------------------------|------------------------|-------------------|
|   | red clay + sand                       | 0                      | 8                 |
| <u>Box 4 Wagnerboro Miss</u><br>(mailing address)   | red sand                              | 8                      | 20                |
|   | chall.                                | 20                     | 25                |
|   | sand                                  | 25                     | 44                |
| WELL LOCATION:<br>sec. <u>8</u> T <u>90</u> N R <u>6</u> E W<br><u>6</u> miles N of Wagnerboro<br>(distance) (direction) (nearest town) | chall. + sand                         | 44                     | 48                |
|   | blue sand                             | 48                     | 54                |
| WELL PURPOSE: <u>none</u><br>(home, irrigation, municipal, industrial)  | chall. + sand                         | 54                     | 58                |
|   | thin rock                             |                        | 58                |
| WELL COMPLETION DATA:   | blue chall.                           | 58                     | 69                |
| (1) diameter (inches) <u>2"</u>   | rock                                  | 69                     | 70                |
| (2) total depth (feet) <u>519</u>   | blue chall.                           | 70                     | 91                |
| (3) static water level (feet) <u>182</u> (below top of ground)  | red rock                              | 91                     | 93                |
| (4) casing <u>steel</u> <u>496</u><br>(material) (depth)  | interbedded white chall.              | 93                     | 133               |
| <u>2"</u> (size) if telescope see back.   | white chall. some rock                | 133                    | 143               |
| (5) screen <u>13'</u> <u>500</u><br>(length) (depth to top)   | Vegetation down                       |                        |                   |
| <u>1 1/4"</u> <u>80 gm. S.S.</u><br>(size) (material)   | blue chall. V                         | 143                    | 256               |
| (6) pump <u>1</u> <u>3 1/2</u><br>(HP) (yield gpm)  | red rock stratum                      | 256                    | 262               |
| (7) electric log <u>no</u><br>(yes or no)   | blue chall.                           | 262                    | 317               |
| (organization running log)  | rock stratum                          | 317                    | 339               |
|   | blue chall.                           | 339                    | 345               |
| (8) how well bottom plugged <u>steel pump</u>   | red rock stratum + chall.             | 343                    | 385               |
|   | blue chall.                           | 385                    | 428               |
| DRILLERS REMARKS: <u>set 155'</u><br><u>cas. in cut off casing</u><br><u>called on completion of well</u>                               | thin rock                             | 428                    | 429               |
|   | chall. + some sand                    | 429                    | 445               |
|   | sand with thin sand                   | 445                    | 457               |
|   | blue chall.                           | 457                    | 477               |
|   | interbedded sand                      | 477                    | 488               |
|   | red chall. + some sand                | 488                    | 495               |
|   | thin sand + chall.                    | 495                    | 517               |
|   | thin sand + chall. + sand             | 517                    | 519               |
|   |                                       | 19'                    | 1 1/2" 80 gm S.S. |
|   |                                       | well 13" 1/2" cas pipe |                   |
|   |                                       | and 5' 1/2" cas on top |                   |
|   |                                       | test in well packer    |                   |
|   |                                       | and set at 25' well    |                   |
|   |                                       | packer below to hold   |                   |

**CODED**

If well telescopes please sketch and show depths.

GROUND LEVEL

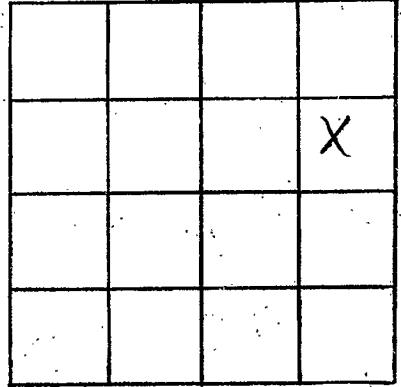

SECTION 8

Please indicate well location X.

ADDITIONAL INFORMATION

If more than one screen,  
show locations of each on sketch.