

MISSISSIPPI
BOARD OF WATER COMMISSIONERS
416 North State Street
Jackson, Mississippi 39201

CODED

WATER WELL DRILLERS LOG

Wayne
J49
6-18-70

June 18 1970 Porter Drilling Co Wayne
date well completed firm name county well located

LANDOWNER: <u>Woodley Jordan</u>	description of formations encountered	from	to
<u>244 Waynesboro Min.</u> (mailing address)	<u>red clay</u>	<u>0</u>	<u>12</u>
	<u>sand</u>	<u>12</u>	<u>77</u>
	<u>clay to 73'</u>		
	<u>schalk</u>	<u>77</u>	<u>85</u>
	<u>sand</u>	<u>85</u>	<u>87 1/2</u>
	<u>clay</u>	<u>87 1/2</u>	<u>88</u>
WELL LOCATION: sec. <u>8</u> T. <u>9</u> (N) R. <u>6</u> (W) <u>5</u> miles <u>N</u> of <u>Waynesboro</u> (distance) (direction) (nearest town)			
WELL PURPOSE: <u>drone</u> (home, irrigation, municipal, industrial)	<u>79' 1 1/2" long pipe</u>		
WELL COMPLETION DATA: (1) diameter (inches) <u>2"</u> (2) total depth (feet) <u>88</u> (3) static water level (feet) <u>73</u> (below/above top of ground) (4) casing <u>steel</u> <u>86'</u> (material) (depth) <u>2"</u> if telescope see back (size) (5) screen <u>3'</u> <u>85'</u> (length) (depth to top) <u>1 1/4"</u> <u>S.S.</u> (size) (material) (6) pump <u>1</u> <u>4</u> (HP) (yield gpm) <u>elec</u> (type power) (7) electric log <u>no</u> (yes or no) (organization running log) (8) how well bottom plugged <u>flush sand</u>			
DRILLERS REMARKS:			


CODED

JUL 7 1970

MISS. Bd. of
WATER COMMISSIONERS

If well telescopes please sketch and show depths.

GROUND LEVEL

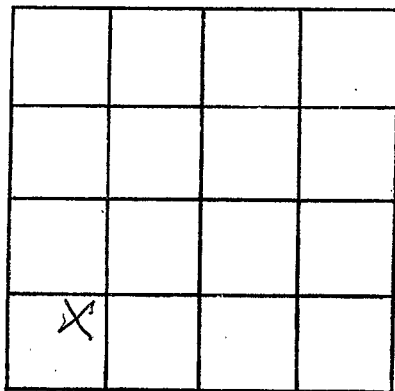

SECTION 8

Please indicate well location X.

ADDITIONAL INFORMATION

If more than one screen,
show locations of each on sketch.