

Wayne
 J 050
 8-67

MISSISSIPPI
 BOARD OF WATER COMMISSIONERS
 416 North State Street
 Jackson, Mississippi 39201

CODED

WATER WELL DRILLERS LOG

19 McDONALD HILL WAYNE
 date well completed 8.15.67 firm name county well located

LANDOWNER: RUSSELL CLARK
WAYNESBORO MISS
 (mailing address)

WELL LOCATION:
 sec. 30 T 9 N R 6 E
3 miles SW of WAYNESBORO
 (distance) (direction) (nearest town)


WELL PURPOSE: HOME
 (home, irrigation, municipal, industrial)

WELL COMPLETION DATA:

- (1) diameter (inches) 4"
- (2) total depth (feet) 475
- (3) static water level (feet) Flow below above top of ground.
- (4) casing Black, 360,
 (material) (depth)
4" if telescope see back.
 (size)
- (5) screen 21', 445
 (length) (depth to top)
3", BLACK PIPE
 (size) (material)
- (6) pump NO NO
 (HP) (yield gpm)
NO
 (type power)
- (7) electric log NO
 (yes or no)
NO
 (organization running log)
- (8) how well bottom plugged VALVE

description of formations encountered	from	to
CLAY	0	7
SAND	7	32
SHALE	32	60
ROCK	60	62
SHALE	62	98
SAND ST SHALE	98	128
FINE SAND	128	190
SOFT SHALE	190	210
FINE SAND	210	225
SAND	225	280
FINE SAND	280	294
SHALE	294	344
ROCK	344	350
SHALE ST OYSTER SHELL	350	370
SAND LIME ST SHALE	370	390
GREEN SHALE	390	419
ROCK	419	420
LIME ROCK ST SHALE	420	442
ROCK	442	445
FINE SAND	445	467
ROCK	467	469
SAND	469	475

CODED

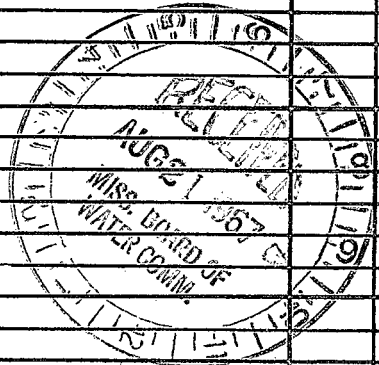

DRILLERS REMARKS:

If well telescopes please sketch and show depths.

GROUND LEVEL

SECTION 30

Please indicate well location X.

ADDITIONAL INFORMATION

If more than one screen, show locations of each on sketch.