

WAYNE
 J 51
 11-30-70

MISSISSIPPI
 BOARD OF WATER COMMISSIONERS
 416 North State Street
 Jackson, Mississippi 39201

CODED

WATER WELL DRILLERS LOG

Nov 30 1970 Roy West Water Wells Wayne
 date well completed firm name county well located

LANDOWNER: Curtis Bishop
 Rt 4
 Wagnersboro Miss
 (mailing address)

description of formations encountered	from	to
	Clay	0
Sand	25	30
Blue clay	30	65
Sand	65	94

WELL LOCATION:
 sec. 19 T 9 R 6 E
 3 miles north of Wagnersboro
 (distance) (direction) (nearest town)

WELL PURPOSE: Home
 (home, irrigation, municipal, industrial)

- WELL COMPLETION DATA:
- (1) diameter (inches) 2 in
 - (2) total depth (feet) 94
 - (3) static water level (feet) 75 below top of ground.
 - (4) casing Galv 89 (material) (depth)
 - (5) screen 5 89 (length) (depth to top)
 1/2 Galv (size) (material)
 - (6) pump 1 (HP) (yield gpm)
 Rea (type power)
 - (7) electric log NO (yes or no)
 (organization running log)
 - (8) how well bottom plugged wash water

CODED

DEC 7 1970

MISS. BD. OF WATER COMMISSIONERS


DEC 1970

MISS. BD. OF WATER COMMISSIONERS

DRILLERS REMARKS:

If well telescopes please sketch and show depths.

GROUND LEVEL

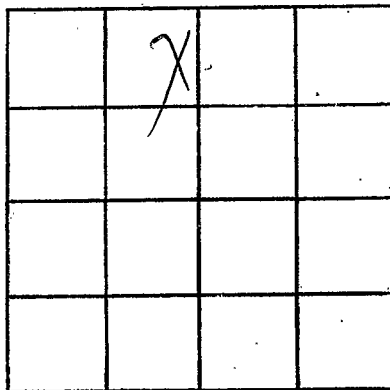

SECTION 19

Please indicate well location X.

ADDITIONAL INFORMATION

If more than one screen, show locations of each on sketch.