

WAYNE
J 52
1-14-70

MISSISSIPPI
BOARD OF WATER COMMISSIONERS
416 North State Street
Jackson, Mississippi 39201

CODED

WATER WELL DRILLERS LOG

Jan 14 1970 date well completed
21 Water Drillers Log firm name
Wayne county well located

LANDOWNER: Eddy Sutton
Box 4 Waverlyboro Miss
(mailing address)

WELL LOCATION:
sec. 30 T 9 N R 6 E
3 miles N of Waynesboro
(distance) (direction) (nearest town)

WELL PURPOSE: Home
(home, irrigation, municipal, industrial)

- WELL COMPLETION DATA:
- (1) diameter (inches) 2"
 - (2) total depth (feet) 166'
 - (3) static water level (feet) 129' below above
top of ground.
 - (4) casing steel 142'
(material) (depth)
2" if telescope see back.
(size)
 - (5) screen none present
(length) (depth to top)
(size) (material)
 - (6) pump 2 5 1/2
(HP) (yield gpm)
elec.
(type power)
 - (7) electric log no
(yes or no)
 - (organization running log)
 - (8) how well bottom plugged open

description of formations encountered	from	to
sand	0	39
Chalk	39	54
sand	54	91
Chalk	91	105
thin rock		105
blue chalk	105	116
thin rock		116
blue chalk	116	141
Thickening rock	141	166

139' 1 1/4" charge pipe

CODED


FEB 9 1970

REC. ED. OF
MISSISSIPPI
WATER COMMISSION

DRILLERS REMARKS:

If well telescopes please sketch and show depths.

GROUND LEVEL

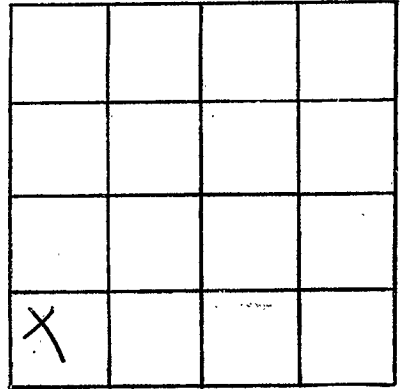

SECTION 20

Please indicate well location X.

ADDITIONAL INFORMATION

If more than one screen,
show locations of each on sketch.