

WAYNE
J 53
4-71

MISSISSIPPI
 BOARD OF WATER COMMISSIONERS
 416 North State Street
 Jackson, Mississippi 39201

CODED

WATER WELL DRILLERS LOG

APRIL 1971 PEEPLES DRILLING CO WAYNE
 date well completed firm name county well located

LANDOWNER: BOB ELLIS
RFD
WAYNES BORO, MISS
 (mailing address)

description of formations encountered	from	to
<u>RED CLAY</u>	<u>0</u>	<u>16</u>
<u>YELLOW SAND</u>	<u>16</u>	<u>25</u>
<u>BLUE CLAY</u>	<u>25</u>	<u>147</u>
<u>GREEN SHALE</u>	<u>147</u>	<u>200</u>
<u>LIMEROCK</u>	<u>200</u>	<u>220</u>
<u>WHITE SAND & LIMEROCK</u>	<u>220</u>	<u>231</u>
<u>LIMEROCK & SHALEY SAND</u>	<u>231</u>	<u>252</u>

WELL LOCATION:
 sec. 13 T. 9 N. R. 6 E.
8 miles NE of WABO
 (distance) (direction) (nearest town)

WELL PURPOSE: HOME
 (home, irrigation, municipal, industrial)

- WELL COMPLETION DATA:
- diameter (inches) 4"
 - total depth (feet) 252
 - static water level (feet) 57 below top of ground.
 - casing IRON 210'
 (material) (depth)
4"
 (size) If telescope see back.
 - screen 4' 227'
 (length) (depth to top)
2" SS
 (size) (material)
 - pump 1/2 15
 (HP) (yield gpm)
ELECTRIC
 (type power)
 - electric log No
 (yes or no)
- (organization running log)
- (8) how well bottom plugged BACK WASH VALVE

CODED


MAY 3 - 1971

DRILLERS REMARKS:

MISS. Bd. OF
 WATER COM.

If well telescopes please sketch and show depths.

GROUND LEVEL

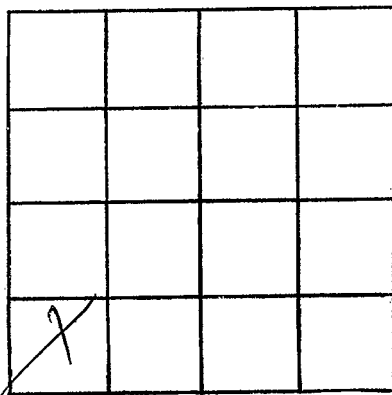

SECTION 13

Please indicate well location X.

ADDITIONAL INFORMATION

If more than one screen,
show locations of each on sketch.