

WAYNE  
J 55  
9-23-71

MISSISSIPPI  
BOARD OF WATER COMMISSIONERS  
416 North State Street  
Jackson, Mississippi 39201

WATER WELL DRILLERS LOG

**CODED**

9-23 1971 CARRS well service WAYNE  
date well completed firm name county well located

LANDOWNER: CLAY Mosley  
WAYNESBORO ~~MS~~  
MISS RT 2  
(mailing address)

WELL LOCATION:  
sec 33 T 9 N R 6 E  
S W  
4 miles ENE of WAYNE  
(distance) (direction) (nearest town)

WELL PURPOSE: HOME  
(home, irrigation, municipal, industrial)

- WELL COMPLETION DATA:
- (1) diameter (inches) 2 1/4"
  - (2) total depth (feet) 73
  - (3) static water level (feet) 45 below above top of ground
  - (4) casing PVC, 69' (material) (depth)  
(size) If telescope see back.
  - (5) screen 4" 69' (length) (depth to top)  
2" PLASTIC (size) (material)
  - (6) pump 3/4 (HP) 8 (yield gpm)  
elect (type power)
  - (7) electric log NO (yes or no)  
(organization running log)
  - (8) how well bottom plugged B.W.V.

description of formations encountered	from	to
Top Soil	0	2
Yellow SANDY CLAY	2	5
PINK CLAY	5	12
Yellowish CLAY	12	15
Fine white SAND	15	28
Med white SAND	28	34
White-Pink CLAY	34	37
PURPLE white CLAY	37	41
Fine white SAND	41	43
PEA GRAVEL	43	48
Fine yellowish SAND	48	51
Med yellowish SAND	51	55
Coarse white SAND + PEA GRAVEL	55	73

**CODED**  
**CODED**


OCT 7 - 1971

MISS. DEPT. OF  
WATER CONTROL

DRILLERS REMARKS: WAS  
STILL IN SAME  
when completed  
well

If well telescopes please sketch and show depths.

GROUND LEVEL

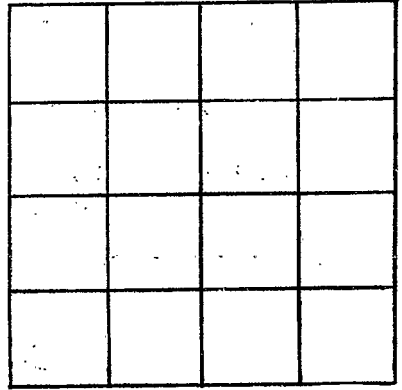

SECTION \_\_\_\_\_

Please indicate well location X.

ADDITIONAL INFORMATION

If more than one screen,  
show locations of each on sketch.