

Wayne  
J 57  
11-9-71

MISSISSIPPI  
BOARD OF WATER COMMISSIONERS  
416 North State Street  
Jackson, Mississippi 39201

DEC 2 1971

WATER WELL DRILLERS LOG


**CODED**

Nov. 9 1971 date well completed  
Porter Drilling & Inc firm name  
11 county well located

LANDOWNER: <u>Bob Caserio</u>	description of formations encountered	from	to
<u>Box 4 Haysboro, Miss</u> (mailing address)	<u>sand</u>	<u>0</u>	<u>6</u>
WELL LOCATION: sec <u>29</u> T <u>9</u> N R <u>6</u> E <u>3</u> miles <u>N</u> of <u>Haysboro</u> (distance) (direction) (nearest town)	<u>red chalk</u>	<u>6</u>	<u>20</u>
WELL PURPOSE: <u>line</u> (home, irrigation, municipal, industrial)	<u>blue chalk</u>	<u>20</u>	<u>28</u>
WELL COMPLETION DATA: (1) diameter (inches) <u>2"</u>	<u>thin rock strata</u>	<u>28</u>	<u>76</u>
(2) total depth (feet) <u>128'</u>	<u>blue chalk</u>	<u>76</u>	<u>101</u>
(3) static water level (feet) <u>90'</u> <sup>below</sup> <sub>above</sub> top of ground.	<u>Verbsburg rock</u>	<u>101</u>	<u>128</u>
(4) casing <u>steel</u> , <u>102'</u> (material) (depth) <u>2"</u> (size) if telescope see back.	<b>CODED</b>	<u>98' 1/4" drop pipe</u>	
(5) screen <u>none used</u> (length) (depth to top) (size) (material)			
(6) pump <u>1 1/2</u> <u>12</u> (HP) (yield gpm) <u>elec</u> (type power)			
(7) electric log <u>no</u> (yes or no) (organization running log)			
(8) how well bottom plugged <u>open</u>			
DRILLERS REMARKS:			

If well telescopes please sketch and show depths.

GROUND LEVEL

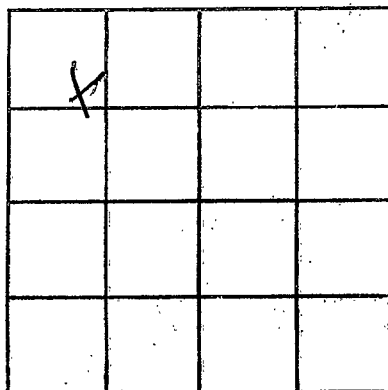

SECTION 29

Please indicate well location X.

ADDITIONAL INFORMATION

If more than one screen, show locations of each on sketch.