

CODED

Wayne
J 60
1-72

MISSISSIPPI
BOARD OF WATER COMMISSIONERS
416 North State Street
Jackson, Mississippi 39201

FEB 15 1972

MISS. BD. OF
WATER COM.

WATER WELL DRILLERS LOG

Jan 1972 Peoples Drilling Co Wayne
date well completed firm name county well located

LANDOWNER: Red Gandy
Rt 4
Waynesboro, Miss.
(mailing address)

description of formations encountered	from	to
Yellow Sandy clay	0	35
Gravel	35	52

WELL LOCATION:
sec. 6 T 9 N R. 6 E
S (W)
3 miles NE of Bayre
(distance) (direction) (nearest town)

Blue clay	52	118
Blue clay & Rock	118	179
Green lime shale & lime Rock streak	179	315

WELL PURPOSE: Home
(home, irrigation, municipal, industrial)

WELL COMPLETION DATA:



- (1) diameter (inches) 4"
- (2) total depth (feet) 525'
- (3) static water level (feet) 173' below top of ground.
- (4) casing Black, 252', (material) (depth)
4" (size) if telescope see back.
- (5) screen 100' perforated pipe (length) (depth to top)
2" Black (size) (material)
- (6) pump 3/4 HP, 8 (yield gpm)
electric (type power)
- (7) electric log no (yes or no)
(organization running log)
- (8) how well bottom plugged Back Wash valve

lime Rock & small sand streak	315	357
Blue shale	357	420
Brown shale & sand streak	420	483
Brown shale & sand	483	510
Blue shale	510	525

CODED

DRILLERS REMARKS:

If well telescopes please sketch and show depths.

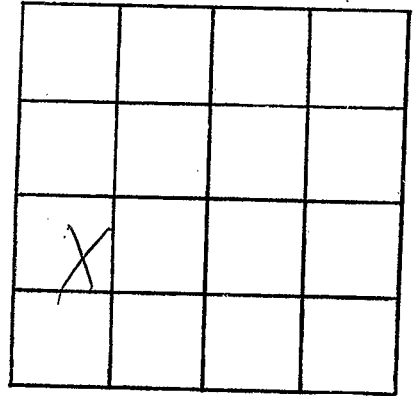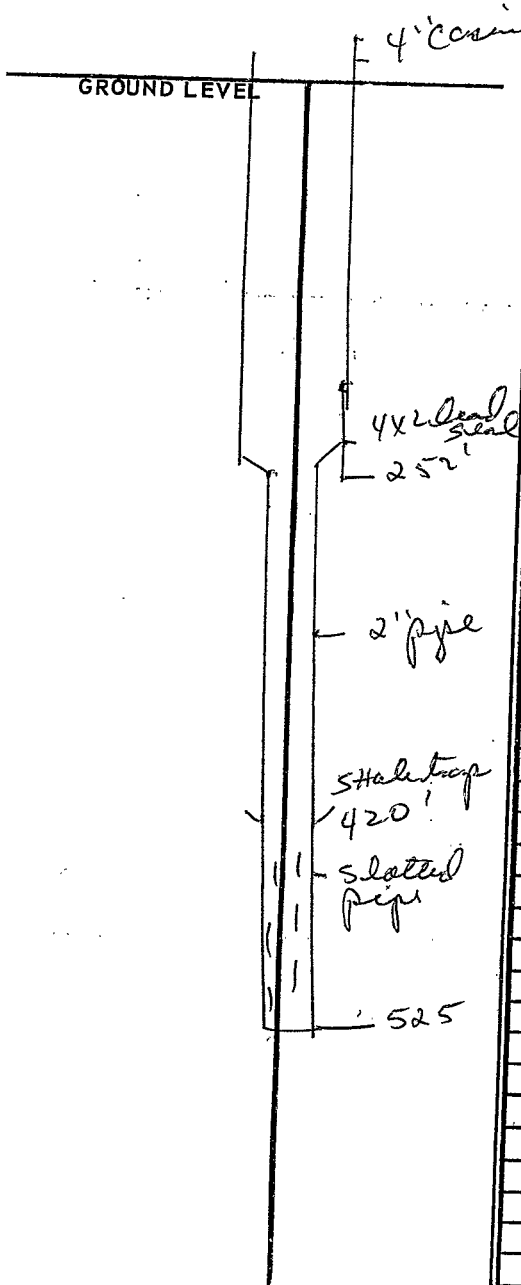

SECTION 6

Please indicate well location X.

ADDITIONAL INFORMATION

Horizontal lines for additional information.

If more than one screen, show locations of each on sketch.