

Wayne
J 61
10-71

MISSISSIPPI
BOARD OF WATER COMMISSIONERS
416 North State Street
Jackson, Mississippi 39201

CODED

WATER WELL DRILLERS LOG

date well completed Oct 1971 firm name Dozier Well Service county well located Wayne

LANDOWNER Howard Buton

description of formations encountered

Mathersville, Miss
(mailing address)

description of formations encountered	from	to
<u>Clay</u>	<u>0</u>	<u>50</u>
<u>Blue maroon</u>	<u>50</u>	<u>125</u>
<u>Sand gravel</u>	<u>125</u>	<u>176</u>

WELL LOCATION:
sec 9 T 90 N R 6 E
S W
16 miles N.E. of Waynesboro
(distance) (direction) (nearest town)

Clay 0-50
Blue maroon 50-125
Sand gravel 125-176

WELL PURPOSE: Home
(home, irrigation, municipal, industrial)

WELL COMPLETION DATA:

- (1) diameter (inches) ✓
- (2) total depth (feet) 176
- (3) static water level (feet) 60 below above top of ground
- (4) casing Gal 152
(material) (depth)
- (size) if telescope see back.
- (5) screen 2x 152
(length) (depth to top)
- (size) (material) 2 Steel
- (6) pump 1 10
(HP) (yield gpm)
- (type power) 1
- (7) electric log No
(yes or no)

CODED

(organization running log)

(8) how well bottom plugged B.W.


FEB 28 1972

FEB 28 1972

DRILLERS REMARKS:

If well telescopes please sketch and show depths.

GROUND LEVEL

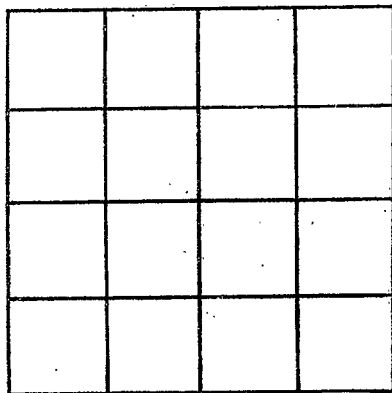

SECTION _____

Please indicate well location X.

ADDITIONAL INFORMATION

If more than one screen, show locations of each on sketch.