

WAYNE
J 62
6-1-72

MISSISSIPPI
BOARD OF WATER COMMISSIONERS
416 North State Street
Jackson, Mississippi 39201

WATER WELL DRILLERS LOG

June 1 1972 Bohr Drilling & Log Wayne
date well completed firm name county well located

LANDOWNER: Waynesboro Country Club
20 Birch Hill Waynesboro Miss
(mailing address)

description of formations encountered	from	to
<u>Clay</u>	<u>0</u>	<u>15</u>
<u>red to brown sand</u>	<u>15</u>	<u>75</u>
<u>7 feet on shell</u>		

WELL LOCATION:
sec 21 T 9 N R 6 E
5 miles NE of Waynesboro
(distance) (direction) (nearest town)

67 1/2' 1/4' drop pipe

WELL PURPOSE: Club & pool
(home, irrigation, municipal, industrial)

down to level 5'

WELL COMPLETION DATA:
(1) diameter (inches) 4"
(2) total depth (feet) 72
(3) static water level (feet) 38 (below above top of ground)
(4) casing steel 60 1/2'
(material) (depth)
4" if telescope see back.
(size)
(5) screen 10' 60 1/2'
(length) (depth to top)
4" 12 slot S.S.
(size) (material)
(6) pump 1 1/2 38
(HP) (yield gpm)
also
(type power)
(7) electric log no
(yes or no)
(organization running log)

(8) how well bottom plugged backwash valve


DRILLERS REMARKS:

DATE 9/1/1972

PROFESSIONAL ENGINEER
MISSISSIPPI REGISTERED

If well telescopes please sketch and show depths.

GROUND LEVEL

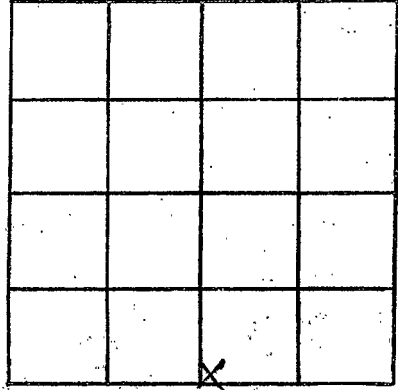

SECTION 21

Please indicate well location X.

ADDITIONAL INFORMATION

If more than one screen,
show locations of each on sketch.