

WAYNE
J 63
5-30-72

MISSISSIPPI
BOARD OF WATER COMMISSIONERS
416 North State Street
Jackson, Mississippi 39201

WATER WELL DRILLERS LOG

May 30 1972 Water Drilling & Log Wayne
date well completed firm name county well located


LANDOWNER: <u>Ray Francis Jordan</u>	description of formations encountered	from	to
<u>At 4 Waynesboro Miss</u> (mailing address)	<u>Clay & sand</u>	0	15
WELL LOCATION: sec. <u>7</u> T. <u>90</u> N. R. <u>6</u> E. <u>W</u> <u>7</u> miles N. <u>Waynesboro</u> (distance) (direction) (nearest town)	<u>Coarse med sand</u>	15	45
WELL PURPOSE: <u>Home</u> (home, irrigation, municipal, industrial)	<u>fine sand & chalk</u>	45	52
WELL COMPLETION DATA:	<u>Chalk</u>	52	72
(1) diameter (inches) <u>2"</u>	<u>Chalk & sand</u>	72	78
(2) total depth (feet) <u>99'</u>	<u>Chalk</u>	78	90
(3) static water level (feet) <u>42'</u> <u>below</u> top of ground.	<u>sand med to coarse</u>	90	99
(4) casing <u>steel</u> , <u>77'</u> (material) (depth)	<u>stagnant on chalk</u>		
<u>2"</u> if telescope see back. (size)			
(5) screen <u>5'</u> , <u>94'</u> (length) (depth to top)	<u>5' 1 1/2" 6 slot SS</u>		
(6) pump <u>1</u> , <u>8 1/2</u> (HP) (yield gpm)	<u>screen with 17' 1/4"</u>		
(7) electric log <u>no</u> (yes or no)	<u>cap pipe test in</u>		
(8) how well bottom plugged <u>flush point</u>	<u>well packer</u>		
DRILLERS REMARKS:	<u>63' 1" drop pipe</u>		
	<u>1 H.P. Blue Bull pump</u>		
	<u>with drop joint - 2" nylon</u>		
	<u>jet assem.</u>		

REC'D JUN 27 1972

MISSISSIPPI WATER COMMISSION

If well telescopes please sketch and show depths.

GROUND LEVEL

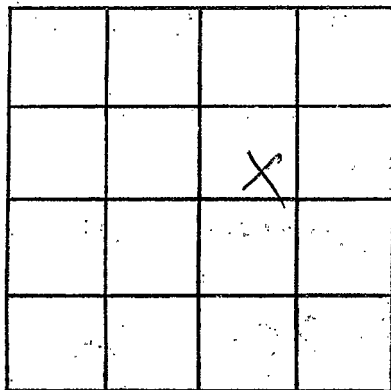

SECTION 8

Please indicate well location X.

ADDITIONAL INFORMATION

Lined area for additional information.

If more than one screen, show locations of each on sketch.