

Wayne
J 65
7-25-72

MISSISSIPPI
BOARD OF WATER COMMISSIONERS
416 North State Street
Jackson, Mississippi 39201

CODED

WATER WELL DRILLERS LOG

July 25 1972 Porter Drilling & Log Wayne
date well completed firm name county well located

LANDOWNER: <u>Clean Blakemore</u>	description of formations encountered	from	to
<u>Box 4 Waynesboro Miss</u> (mailing address) sec. <u>8</u> T. <u>90</u> N. R. <u>6</u> E. W. <u>6</u> miles <u>N</u> of <u>Waynesboro</u> (distance) (direction) (nearest town)	clay	0	18
	sand & chalk	18	30
	chalk	30	32
	thin rock	32	42
	rock strata	42	56
	blue chalk	56	74
	Wicksburg rock	74	105

WELL PURPOSE: house
(home, irrigation, municipal, industrial)

- WELL COMPLETION DATA:
- (1) diameter (inches) 2"
 - (2) total depth (feet) 10.5'
 - (3) static water level (feet) 91 (below/above top of ground)
 - (4) casing steel 97'
(material) (depth)
2" (size) if telescope see back.
 - (5) screen none used
(length) (depth to top)
 - (6) pump 1 1/2 2 gal
(HP) (yield gpm)
elec. (type power)
 - (7) electric log no
(yes or no)
 - (organization running log)
 - (8) how well bottom plugged open

shell funnel set on case
at 91'
94' 1/4" drop pipe

CODED


SEP 5 1972

DRILLERS REMARKS:

MISS. DEPT. OF
WATER RESOURCES

If well telescopes please sketch and show depths.

GROUND LEVEL

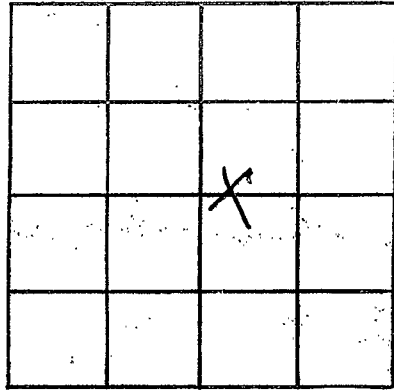

SECTION 8

Please indicate well location X.

ADDITIONAL INFORMATION

If more than one screen, show locations of each on sketch.