

Wayne
J 66
7-22-72

MISSISSIPPI
BOARD OF WATER COMMISSIONERS
416 North State Street
Jackson, Mississippi 39201

CODED

WATER WELL DRILLERS LOG

July 22 1972 *Porter Drilling & Log* Wayne
date well completed firm name county well located

LANDOWNER: <i>Joe Howard</i>	description of formations encountered	from	to
<i>At 2 Magneshboro Town</i> (milling address)	<i>red clay</i>	<i>0</i>	<i>3</i>
WELL LOCATION: sec. <i>33</i> T. <i>9</i> S. R. <i>6</i> E. <i>W</i> <i>3</i> miles <i>NE</i> of <i>Magneshboro</i> (distance) (direction) (nearest town)	<i>course sand</i>	<i>3</i>	<i>24</i>
WELL PURPOSE: <i>home</i> (home, irrigation, municipal, industrial)	<i>sand & chalk</i>	<i>24</i>	<i>38</i>
WELL COMPLETION DATA:	<i>chalk</i>	<i>38</i>	<i>72</i>
(1) diameter (inches) <i>2"</i>	<i>clean sand</i>	<i>72</i>	<i>77 1/2</i>
(2) total depth (feet) <i>77 1/2</i>	<i>stratum on chalk</i>		
(3) static water level (feet) <i>43</i> below top of ground.	<i>3' 1/4" belt ss.</i>		
(4) casing <i>steel</i> <i>75 1/2</i> (material) (depth)	<i>test on with packer</i>		
<i>2"</i> (size) if telescope see back.	<i>65' 1/4" drop pipe</i>		
(5) screen <i>3'</i> <i>74'</i> (length) (depth to top)			
<i>1/4"</i> (size) <i>belt ss.</i> (material)			
(6) pump <i>1</i> <i>12</i> (HP) (yield gpm)			
<i>elec</i> (type power)			
(7) electric log <i>no</i> (yes or no)			
(organization running log)			
(8) how well bottom plugged <i>flush joint</i>			
DRILLERS REMARKS <i>SS</i>			


CODED

SFD 5 10 72
1512

MISS. BD. OF
WATER COMMISSIONERS

If well telescopes please sketch and show depths.

GROUND LEVEL

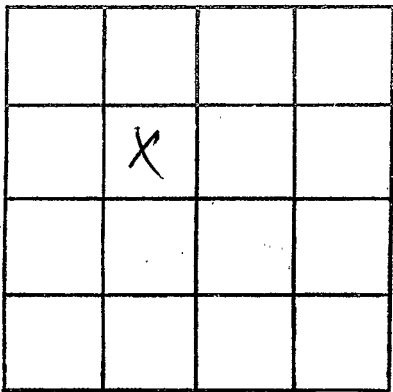

SECTION 33

Please indicate well location X.

ADDITIONAL INFORMATION

A series of horizontal lines for writing additional information.

If more than one screen, show locations of each on sketch.