

Wayne
J68
9-19-72

MISSISSIPPI
BOARD OF WATER COMMISSIONERS
416 North State Street
Jackson, Mississippi 39201

WATER WELL DRILLERS LOG **CODED**

SEPT 19 1972 Ms. ILWAIN WATER WELL SER. WAYNE
date well completed firm name county well located

LANDOWNER:
JOE ESTES
RT 2 WAYNESBORO
(mailing address)

description of formations encountered	from	to
Red Clay + Sand	0	11
Clay	11	15
Sand + Clay	15	28
Water Sand	28	45

WELL LOCATION:
sec. 31 T 9 N R 16 E
2 miles NE of W' BORO
(distance) (direction) (nearest town)

WELL PURPOSE: HOME
(home, irrigation, municipal, industrial)

- WELL COMPLETION DATA:
- (1) diameter (inches) 2"
 - (2) total depth (feet) 45'
 - (3) static water level (feet) 31' below top of ground.
 - (4) casing PVC 40' (material) (depth)
2" (size) if telescope see back.
 - (5) screen 5' 40' (length) (depth to top)
1/4" PVC .008 (size) (material)
 - (6) pump 3/4 5.5 (HP) (yield gpm)
110 AC (type power)
 - (7) electric log NO (yes or no)
 - (8) how well bottom plugged

CODED


SEP 22 1972

DRILLERS REMARKS:

MISS. DEP. OF
AGRICULTURE

If well telescopes please sketch and show depths.

GROUND LEVEL

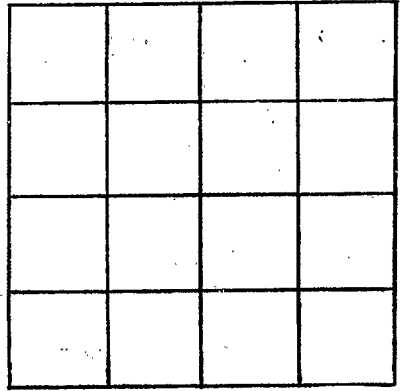

SECTION _____

Please indicate well location X.

ADDITIONAL INFORMATION

If more than one screen, show locations of each on sketch.