

BOARD OF WATER COMMISSIONERS

416 North State Street

Jackson, Mississippi 39201

Wayne

J 69

11-14-72

Nov. 14

WATER WELL DRILLERS LOG

CODED

72 Port Drilling & Drilling Co. Wayne

date well completed

firm name

county well located

LANDOWNER:

George Hayes

description of formations encountered

from

to

Box 2 Waynesboro, Miss (mailing address)

red clay 0 18  
sand & chert 18 45  
sand 45 73  
strat on chalk

WELL LOCATION:

sec 2 T 20 N R 6 E of Waynesboro (distance) miles (direction) (nearest town)

WELL PURPOSE: Home (home, irrigation, municipal, industrial)

6' 1 1/4" 60 ga S.S. screwed on end of Cas. 60' 1 1/4" clay pipe

WELL COMPLETION DATA:

- (1) diameter (inches) 2"
(2) total depth (feet) 69'
(3) static water level (feet) 44' below top of ground
(4) casing (material) steel (depth) 63'
(5) screen (length) 6' (depth to top) 63'
(6) pump (HP) 1 (yield gpm) 12
(7) electric log (yes or no) no

CODED

(organization running log)


(8) how well bottom plugged

DRILLERS REMARKS:

DEC 15 1972

If well telescopes please sketch and show depths.

GROUND LEVEL

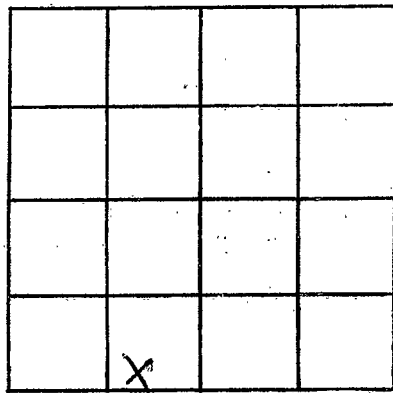

SECTION 29

Please indicate well location X.

ADDITIONAL INFORMATION

If more than one screen,  
show locations of each on sketch.