

WAYNE
J 70
12-12-72

MISSISSIPPI
BOARD OF WATER COMMISSIONERS
416 North State Street
Jackson, Mississippi 39201

CODED

WATER WELL DRILLERS LOG

Dec 12 1972 date well completed
Boyer Drilling & Pipe firm name
Wayne county well located

LANDOWNER: Roland Clark
Grandma building
Opalen Dr. Magnolia
(mailing address)

description of formations encountered	from to	
red clay	0	15
sand	15	68
chalk	68	71

WELL LOCATION:
sec. 29 T 9 N R 6 E
2 miles NE Magnolia
(distance) (direction) (nearest town)

5' 1 1/4" 62' S.S.

WELL PURPOSE: home
(home, irrigation, municipal, industrial)

sweetest on end of case

WELL COMPLETION DATA:

- (1) diameter (inches) 2"
- (2) total depth (feet) 68'
- (3) static water level (feet) 48' below top of ground.
- (4) casing steel 62' (material) (depth)
2' if telescope see back.
- (5) screen 5' 62' (length) (depth to top)
1 1/4" 62' S.S. (size) (material)
- (6) pump 1 7 1/2 (HP) (yield gpm)
elec. (type power)
- (7) electric log no (yes or no)

with wash on valve on end of screen

59' 1 1/4" drop pipe

(organization running log)


(8) how well bottom plugged
wash on valve

DRILLERS REMARKS:

DEC 10 1972

If well telescopes please
sketch and show depths.

GROUND LEVEL

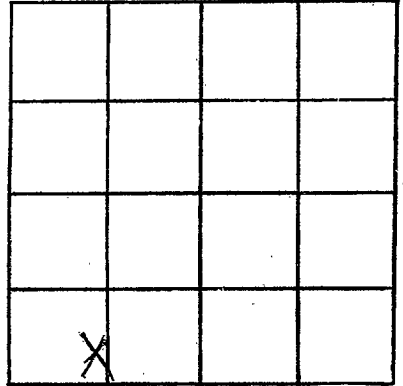

SECTION 29

Please indicate well location X.

ADDITIONAL INFORMATION

If more than one screen,
show locations of each on sketch.