

BOARD OF WATER COMMISSIONERS

416 North State Street  
Jackson, Mississippi 39201

**CODED**

WAYNE

J 71

12-19-72

WATER WELL DRILLERS LOG

Dec. 19 1972  
date well completed

22 Power Drilling Corp  
firm name

Wayne  
county well located

LANDOWNER: L. Mc Lemore

description of formations encountered

from to

24 Mayesboro, Miss  
(mailing address)

red clay	0	12
sand	12	18
red chalk	18	28
blue chalk	28	40
thin rock strata	40	58
blue chalk	58	114
Vicksburg, rock	114	146

WELL LOCATION:

sec 29 T 90 S R 6 E W  
22 miles N Mayesboro  
(distance) (direction) (nearest town)

WELL PURPOSE: Home  
(home, irrigation, municipal, industrial)

WELL COMPLETION DATA:

- (1) diameter (inches) 2"
- (2) total depth (feet) 146
- (3) static water level (feet) 100 (below above top of ground)
- (4) casing steel, 115'  
(material) (depth)
- 2" (size) if telescope see back.
- (5) screen none used  
(length) (depth to top)
- (size) (material)
- (6) pump 1 1/2 7  
(HP) (yield gpm)
- elec  
(type power)
- (7) electric log no  
(yes or no)
- (organization running log)
- (8) how well bottom plugged open


111' 1 1/2' long pipe

DRILLERS REMARKS:

JAN 10 1973

If well telescopes please sketch and show depths.

GROUND LEVEL

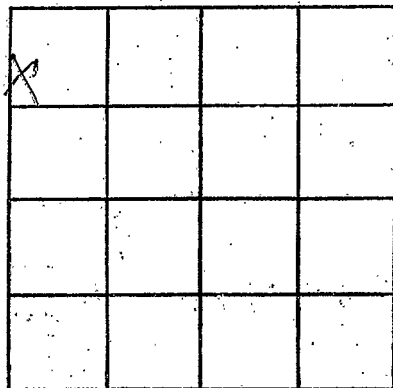

SECTION 29

Please indicate well location X.

ADDITIONAL INFORMATION

If more than one screen,  
show locations of each on sketch.