

WAYNE

J 73

1-22-73

MISSISSIPPI BOARD OF WATER COMMISSIONERS
416 North State Street
Jackson, Mississippi 39201

CODED

WATER WELL DRILLERS LOG

1-22-73
date well completed

19 McILWAIN WATER WELL SER
firm name


WAYNE
county well located

LANDOWNER:	description of formations encountered	from	to
ELBERT (RED) WINDHAM			
Rt 2 WAYNESBORO (mailing address)	SAND	8	24
WELL LOCATION:	CLAY	24	27
sec. 32 T 9 N R 6 E	SAND	27	43
2 miles NE of W. BORO (distance) (direction) (nearest town)	CLAY	43	45
WELL PURPOSE: HOME (home, irrigation, municipal, industrial)	SAND	45	56
WELL COMPLETION DATA:	CLAY	56	60
(1) diameter (inches) 2"	SAND	60	63
(2) total depth (feet) 75	CLAY	63	64
(3) static water level (feet) 47 below top of ground.	SAND	64	75
(4) casing PUC 65' (material) (depth)			
2" If telescope see back. (size)			
(5) screen 10' 65' (length) (depth to top)			
2" PUC .008 (size) (material)			
(6) pump 1 10 (HP) (yield gpm)			
220 AC (type power)			
(7) electric log NO (yes or no)			
(organization running log)			
(8) how well bottom plugged			
DRILLERS REMARKS:			

FEB 7 1973

If well telescopes please sketch and show depths.

GROUND LEVEL

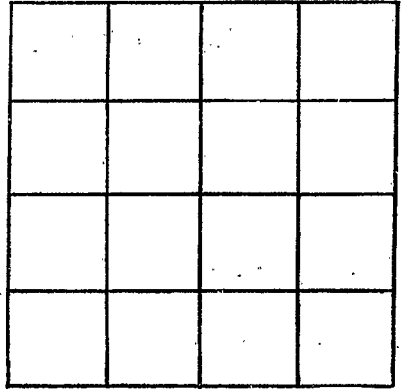

SECTION _____

Please indicate well location X.

ADDITIONAL INFORMATION

If more than one screen,
show locations of each on sketch.