

WAYNE
J 74
4-5-73

MISSISSIPPI
 BOARD OF WATER COMMISSIONERS
 416 North State Street
 Jackson, Mississippi 39201

CODED

WATER WELL DRILLERS LOG


4-5-73 date well completed **MISSISSIPPI WATER WELL SER** firm name **WAYNE** county well located

LANDOWNER:	description of formations encountered	from	to
HOMER JOHNSON	RED CLAY	0	12
RT 2 WAYNESBORO MISS (mailing address)	RED SAND	12	20
WELL LOCATION: sec 29 T 9 N R 6 E 4 miles NE of W' BORO (distance) (direction) (nearest town)	WHITE SAND	20	38
WELL PURPOSE: HOME (home, irrigation, municipal, industrial)	CLAY	38	48
WELL COMPLETION DATA: (1) diameter (inches) 2" (2) total depth (feet) 57' (3) static water level (feet) 45' below top of ground (4) casing PVC 52' (material) (depth) 2" if telescope see back. (size) (5) screen 5' 52' (length) (depth to top) 2' PVC (size) (material) (6) pump 3/4 6 (HP) (yield gpm) 110 AC (type power) (7) electric log Y (yes or no) (organization running log) (8) how well bottom plugged	SAND	48	57
DRILLERS REMARKS:	ADD 20 FEET		

CODED

If well telescopes please sketch and show depths.

GROUND LEVEL

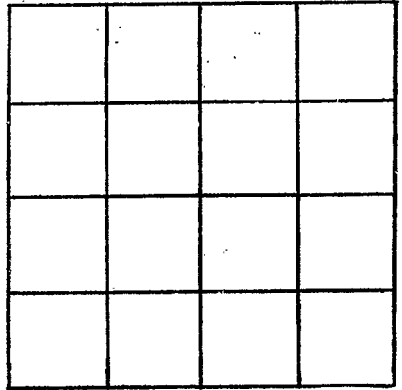

SECTION _____

Please indicate well location X.

ADDITIONAL INFORMATION

If more than one screen,
show locations of each on sketch.