

WAYNE

J 76

3-16-73

MISSISSIPPI  
 BOARD OF WATER COMMISSIONERS  
 416 North State Street  
 Jackson, Mississippi 39201

**CODED**

WATER WELL DRILLERS LOG

March 16 1973 Robert D. Williams & Son Wayne  
 date well completed firm name county well located

LANDOWNER: Carl Marsh

description of formations encountered

from

to

At 2 Waynesboro Min  
 (mailing address)

red clay 0 8  
sand, white  
red to brown 8 65  
red sand & chalk 65 68  
red sand on chalk

WELL LOCATION:

sec 29 T 9 N R 6 E  
25 miles NE of Waynesboro  
 (distance) (direction) (nearest town)

WELL PURPOSE: home  
 (home, irrigation, municipal, industrial)

WELL COMPLETION DATA:

- (1) diameter (inches) 2"
- (2) total depth (feet) 64'
- (3) static water level (feet) 44' <sup>below</sup> <sub>above</sub> top of ground.
- (4) casing steel 61'  
 (material) (depth)
- 2 if telescope see back.  
 (size)
- (5) screen 3' 61'  
 (length) (depth to top)
- 1 1/2 6 slot 5.5  
 (size) (material)
- (6) pump 1 12  
 (HP) (yield gpm)
- elec.  
 (type power)
- (7) electric log no  
 (yes or no)
- (organization running log)

5.5' 1 1/2" drop pipe  
3' 1 1/2" 6 slot 5.5  
screened on case


**CODED**

(8) how well bottom plugged flush ground

DRILLERS REMARKS:

If well telescopes please sketch and show depths.

GROUND LEVEL

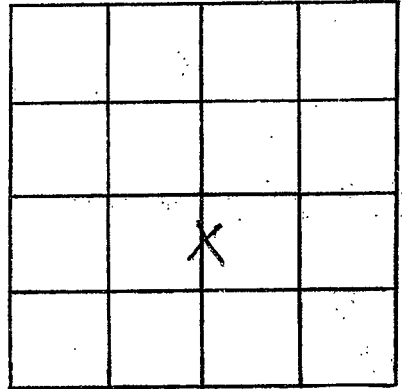

SECTION 29

Please indicate well location X.

ADDITIONAL INFORMATION

If more than one screen, show locations of each on sketch.