

WAYNE
J 78
5-10-73

MISSISSIPPI
BOARD OF WATER COMMISSIONERS
416 North State Street
Jackson, Mississippi 39201

CODED

WATER WELL DRILLERS LOG

May 10 1973 date well completed
Bart Drilling & Exp Wayne firm name
Wayne county well located

LANDOWNER: Robert Lee King

description of formations encountered

from to

Landmark - Contractor
222 Magnolia Ave
(mailing address)

15' sand	0	15
15' shale	15	30
15' chert	30	45
15' sand	45	60
15' chert	60	75

WELL LOCATION:
sec. 29 T. 90 N. R. 6 E. S. 3 W.
3 miles N.E. of Magnolia
(distance) (direction) (nearest town)

WELL PURPOSE: Home
(home, irrigation, municipal, industrial)

WELL COMPLETION DATA:

- (1) diameter (inches) 2"
- (2) total depth (feet) 66'
- (3) static water level (feet) 1' below top of ground
- (4) casing (material) 1" galv. (depth) 60'
- (5) screen (length) 6' (depth to top) 60'
- (6) pump (HP) 1/2 (yield gpm) 100
- (7) electric log (yes or no)
- (8) how well bottom plugged

6' 1" to 60' galv. SS.
no screen on end of cas.
57' 1/2" drop pipe


CODED

DRILLERS REMARKS:

MAY 5 1973

If well telescopes please sketch and show depths.

GROUND LEVEL

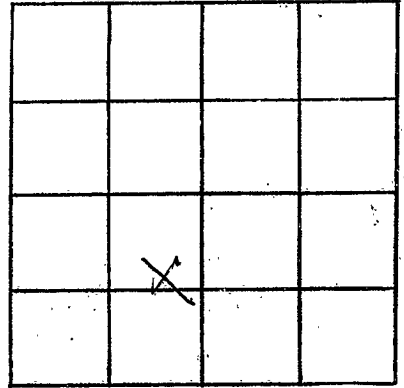

SECTION 29

Please indicate well location X.

ADDITIONAL INFORMATION

If more than one screen,
show locations of each on sketch.