

MISSISSIPPI

BOARD OF WATER COMMISSIONERS

416 North State Street

Jackson, Mississippi 39201

CODED

WATER WELL DRILLERS LOG

WAYNE
J 79
5-7-73

May 7 1973 Proctor Drilling, Inc. Wayne
date well completed firm name county well located

LANDOWNER: Lamonty Bishop description of formations encountered from to

212 W. Harnesboro, Mo. (mailing address)
sandy mud clay
chalk
sand
sandy shale
21 18
19 21

WELL LOCATION:
sec 33 T 9 N R 6 E
S W
3 miles NE of Harnesboro
(distance) (direction) (nearest town)

WELL PURPOSE: home
(home, irrigation, municipal, industrial)

WELL COMPLETION DATA:

- (1) diameter (inches) 2"
- (2) total depth (feet) 77'
- (3) static water level (feet) 61' below top of ground.
- (4) casing steel, 72'
(material) (depth)
2" if telescope see back.
(size)
- (5) screen 5', 72'
(length) (depth to top)
1/4" hard S.S.
(size) (material)
- (6) pump 1, 10
(HP) (yield gpm)
elec.
(type power)
- (7) electric log no
(yes or no)
Proctor Drilling
(organization running log)
- (8) how well bottom plugged flush gravel

5' 1/2" hard S.S.
enclosed on end of casing
67' 1/2" drain pipe

CODED


DRILLERS REMARKS:

JUN 5 1973

MISC. NO. 0
WATER

If well telescopes please sketch and show depths.

GROUND LEVEL

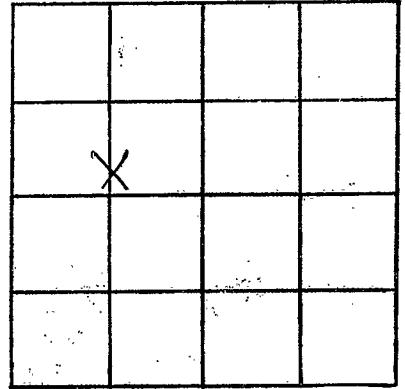

SECTION 33

Please indicate well location X.

ADDITIONAL INFORMATION

If more than one screen,
show locations of each on sketch.