

WAYNE
J81
9-15-73

MISSISSIPPI
 BOARD OF WATER COMMISSIONERS
 416 North State Street
 Jackson, Mississippi 39201

INDEXED

WATER WELL DRILLERS LOG

SEPT 15, 73 McILWAIN WATER WELL SERVICE WAYNE

date well completed **RT. 2, m BOX 37** county well located
WAYNESBORO, MISS.

LANDOWNER:

WALTER L. CLANTON

RT 4 WAYNESBORO
 (mailing address)

WELL LOCATION:

sec. **17** T. **9** N. R. **6**
5 miles **NE** of **W BORO**
 (distance) (direction) (nearest town)

WELL PURPOSE: HOME
 (home, irrigation, municipal, industrial)

WELL COMPLETION DATA:

- (1) diameter (inches) **2"**
- (2) total depth (feet) **65'**
- (3) static water level (feet) **54'** below above top of ground.
- (4) casing **PVC** **55'**
 (material) (depth)
2" if telescope see back.
 (size)
- (5) screen **10'** **55'**
 (length) (depth to top)
2" **PVC .008**
 (size) (material)
- (6) pump **1/2** **6**
 (HP) (yield gpm)
110 AC
 (type power)
- (7) electric log **NO.**
 (yes or no)
- (organization running log)
- (8) how well bottom plugged

description of formations encountered

from to

RED CLAY	0	8
SAND	8	14
CLAY	14	18
SAND	18	35
SAND AND CLAY STREAKS	35	45
CLAY	45	53
SAND	53	65


SAND
DRILLED

DRILLERS REMARKS:

SEP 10 1973
SEP 10 1973

If well telescopes please sketch and show depths.

GROUND LEVEL

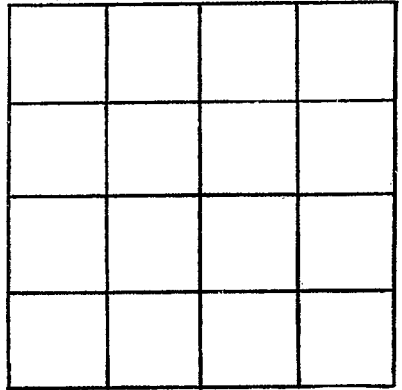

SECTION _____

Please indicate well location X.

ADDITIONAL INFORMATION

If more than one screen, show locations of each on sketch.