

WAYNE

J 82

8-14-73

MISSISSIPPI BOARD OF WATER COMMISSIONERS  
416 North State Street  
Jackson, Mississippi 39201

SEP 12 1973

CODED

MISS. BD. OF WATER COMM.

WATER WELL DRILLERS LOG

Aug 14 1973  
date well completed

Porter Drilling & Exp  
firm name

Wayne  
county well located

LANDOWNER:

Jimmy West

description of formations encountered

from

to

At 4 Wayneboro Miss  
(mailing address)

WELL LOCATION:

sec 20 T 9 N R 6 E  
3 miles N of Wayneboro  
(distance) (direction) (nearest town)

WELL PURPOSE:

home, irrigation, municipal, industrial

WELL COMPLETION DATA:

(1) diameter (inches) 2"

(2) total depth (feet) 181

(3) static water level (feet) 146 below top of ground

(4) casing (material) steel (depth) 150

2" if telescope see back.  
(size)

(5) screen (length) none (depth to top) none

(size) (material)

(6) pump 2 (HP) 4 (yield gpm)

elec. (type power)

(7) electric log no (yes or no)

(organization running log)

(8) how well bottom plugged open


DRILLERS REMARKS:

red clay	0	12
sand	12	45
sand & chalk	45	60
sand	60	81
sand & chalk	81	86
red chalk	86	90
blue chalk	90	108
rock stratum	108	116
blue chalk	116	128
rock stratum	128	135
blue chalk	135	148
Vicksburg	148	181

147' 1 1/4' deep gauge  
21' 1' sand gauge below  
job  
CODED

If well telescopes please sketch and show depths.

GROUND LEVEL

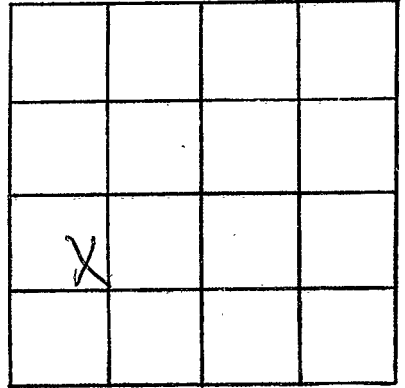

SECTION 20

Please indicate well location X.

ADDITIONAL INFORMATION

If more than one screen,  
show locations of each on sketch.