

BOARD OF WATER COMMISSIONERS

416 North State Street

Jackson, Mississippi 39201

CODED

WAYNE

J83

10-5-73

WATER WELL DRILLERS LOG

Oct 5 1973  
date well completed

Porter Drilling Co  
firm name

Wayne  
county well located

LANDOWNER: Raymond  
Everette

description of formations encountered  
from to

Rt 2 N Magnolia  
(mailing address)

clay & sand 0 28  
sand 28 42  
shale on  
shaly sand

WELL LOCATION:

sec 33 T 9 N R 6 E  
3 miles N.E. of Magnolia  
(distance) (direction) (nearest town)

3' 1 1/4" to slot S.S.

WELL PURPOSE: none  
(home, irrigation, municipal, industrial)

screened on end of case

WELL COMPLETION DATA:

- (1) diameter (inches) 2'
- (2) total depth (feet) 42'
- (3) static water level (feet) 30' (below top of ground)
- (4) casing steel 39' (material) (depth)  
2' (size) if telescope see back.
- (5) screen 3' 39' (length) (depth to top)  
1 1/2" belt S.S. (size) (material)
- (6) pump 1 (HP) 10 (yield gpm)  
elec. (type power)
- (7) electric log no (yes or no)
- (organization running log)
- (8) how well bottom plugged  
dash point


CODED  
36' 1 1/4" drop pipe

DRILLERS REMARKS:

OCT 9 1973

If well telescopes please  
sketch and show depths.

GROUND LEVEL

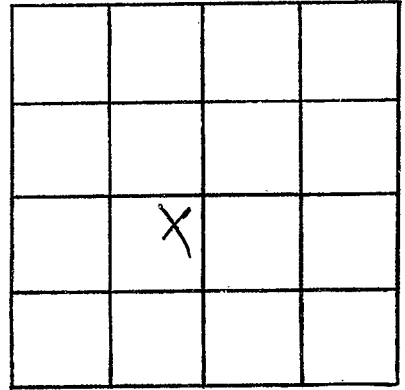

SECTION 33

Please indicate well location X.

ADDITIONAL INFORMATION

If more than one screen,  
show locations of each on sketch.