

WAYNE
J 85
10-20-73

MISSISSIPPI
 BOARD OF WATER COMMISSIONERS
 416 North State Street
 Jackson, Mississippi 39201

WATER WELL DRILLERS LOG

Oct 20, 1973
 date well completed

McILWAIN WATER WELL SERVICE WAYNE

RT. 2, Box 37

county well located

WAYNESBORO, MISS. 39367

LANDOWNER:
Glynn McILWAIN
RT 2 WAYNESBORO
 (mailing address)

WELL LOCATION:
 sec. **34** T. **9** N R. **6** W
5 miles **NE** of **W'BORO**
 (distance) (direction) (nearest town)

| description of formations encountered | from | to |
|---------------------------------------|------|-----|
| RED CLAY | 0 | 9 |
| RED SAND | 9 | 14 |
| WHITE SAND | 14 | 18 |
| SAND + CLAY | 18 | 28 |
| PINK + WHITE CLAY | 28 | 40 |
| BLUE CLAY | 40 | 48 |
| FINE SAND | 48 | 51 |
| CLAY | 51 | 54 |
| CLAY + THIN STREAKS OF SAND | 54 | 62 |
| GREY CLAY | 62 | 92 |
| STREAKS OF LIMY ROCKS + CLAY | 92 | 112 |
| DARK BROWN + GREY CLAY | 112 | 140 |
| HONEYCOMB ROCK | 140 | 195 |

WELL PURPOSE: **HOME**
 (home, irrigation, municipal, industrial)

WELL COMPLETION DATA:

(1) diameter (inches) **2"**

(2) total depth (feet) **195'**

(3) static water level (feet) **110'** below top of ground.

(4) casing **GALV.** **147'**
 (material) (depth)
2" If telescope see back.
 (size)

(5) screen **NONE**
 (length) (depth to top)
 (size) (material)

(6) pump **1 1/2** **5**
 (HP) (yield gpm)
220 AC
 (type power)

(7) electric log **NO**
 (yes or no)

(organization running log) **SHALE TRAP**

(8) how well bottom plugged **TRAP**

CODED


NOV 6 1973

DRILLERS REMARKS:

ISS. BY
 COMB.

If well telescopes please sketch and show depths.

GROUND LEVEL

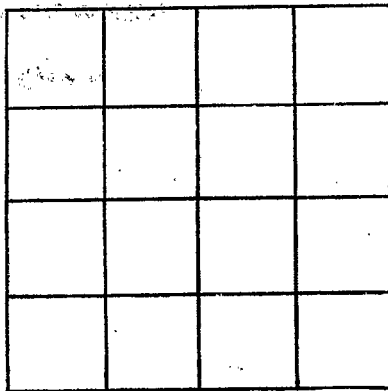

SECTION _____

Please indicate well location X.

ADDITIONAL INFORMATION

If more than one screen, show locations of each on sketch.