

WAYNE
J 88
11-10-73

MISSISSIPPI
BOARD OF WATER COMMISSIONERS
416 North State Street
Jackson, Mississippi 39201

CODED

WATER WELL DRILLERS LOG

Nov. 10, 1973¹⁹
date well completed

McILWAIN WATER WELL SERVICE

WAYNE

RT. 2m BOX 37

county well located

WAYNESBORO, MISS. 39367

LANDOWNER:

DECELL DYESS

RT 2 WAYNESBORO, Miss.
(mailing address)

description of formations
encountered

RED CLAY

from

to

0

12

RED SAND

12

13

YELLOW CLAY

13

15

FINE SAND

15

18

WHITE & PINK CLAY

18

27

SAND **CODED**

27

45

SAND + CLAY
STREAKS

45

60

SAND

60

75

WELL LOCATION:

sec. 32 T 9 N R 6 W

3 miles NE of W'BORO
(distance) (direction) (nearest town)

WELL PURPOSE:

Home
(home, irrigation, municipal, industrial)

WELL COMPLETION DATA:

- (1) diameter (inches) 2"
- (2) total depth (feet) 75'
- (3) static water level (feet) 52' below top of ground.
- (4) casing PVC 65'
(material) (depth)
2"
(size) if telescope see back.
- (5) screen 10' 65'
(length) (depth to top)
2"
(size) (material)
- (6) pump 1 10
(HP) (yield gpm)
110 AC
(type power)
- (7) electric log No.
(yes or no)

(organization running log)

(8) how well bottom plugged


DRILLERS REMARKS:

DEC - 7 1973

MISS. DEP. OF
WATER RESOURCES
JACKSON, MISSISSIPPI

If well telescopes please sketch and show depths.

GROUND LEVEL

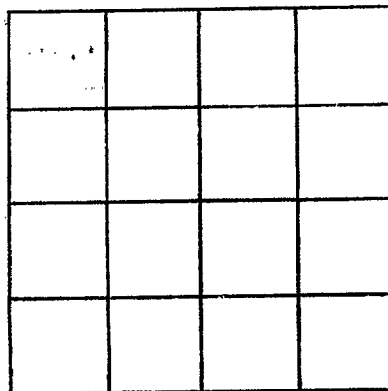

SECTION _____

Please indicate well location X.

ADDITIONAL INFORMATION

If more than one screen, show locations of each on sketch.