

WAYNE
J 91
12-27-73

MISSISSIPPI
BOARD OF WATER COMMISSIONERS
416 North State Street
Jackson, Mississippi 39201

CODED

WATER WELL DRILLERS LOG

Dec 27 1973 Porter Drilling & Log Wayne
date well completed firm name county well located

LANDOWNER: W.C. Satterwhite

description of formations encountered from to

At 4 Waynesboro Miss
(gilling address)

red clay	0	8
sand & Chalk	8	33
Chalk	33	44
sand	44	69
blue Chalk	69	90
rock strata	90	110
blue Chalk	110	136
Wachburg	136	168

WELL LOCATION:
sec 30 T 9 N R 6 E
3 miles N of Waynesboro
(distance) (direction) (nearest town)

WELL PURPOSE: home
(home, irrigation, municipal, industrial)

WELL COMPLETION DATA:

134' 1 1/4" down pipe

- (1) diameter (inches) 2"
- (2) total depth (feet) 168'
- (3) static water level (feet) 127' (below/above top of ground)
- (4) casing steel 138'
(material) (depth)
2" if telescope see back.
(size)
- (5) screen none used
(length) (depth to top)
(size) (material)
- (6) pump 2 5 1/2
(HP) (yield gpm)
elec.
(type power)
- (7) electric log none
(yes or no)
(organization running log)
- (8) how well bottom plugged open


CODED

DRILLERS REMARKS:

RECORDED
INDEXED
JAN 29 1974

If well telescopes please sketch and show depths.

GROUND LEVEL

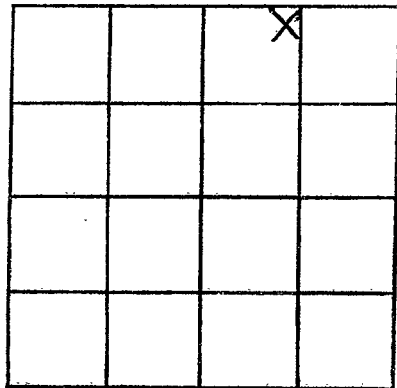

SECTION 30

Please indicate well location X.

ADDITIONAL INFORMATION

If more than one screen,
show locations of each on sketch.