

WAYNE
J 92
2-6-74

MISSISSIPPI
 BOARD OF WATER COMMISSIONERS
 416 North State Street
 Jackson, Mississippi 39201

CODED

WATER WELL DRILLERS LOG

FEB 6, 1974 19 McILWAIN WATER WELL SERVICE WAYNE
 date well completed RT. 2 BOX 37 county well located

WAYNESBORO, MISS. 39367

LANDOWNER:
BROWN WEAVER
Rt 4 Waynesboro, Miss.
 (mailing address)

description of formations encountered	from	to
<u>Red sand and streaks of clay</u>	<u>0</u>	<u>40</u>
<u>White sand</u>	<u>40</u>	<u>55</u>

WELL LOCATION:
 sec. 8 T 9 N R 6
6 miles NE of W'BORO
 (distance) (direction) (nearest town)

WELL PURPOSE: HOME
 (home, irrigation, municipal, industrial)

- WELL COMPLETION DATA:
- (1) diameter (inches) 2"
 - (2) total depth (feet) 55'
 - (3) static water level (feet) 43' below top of ground.
 - (4) casing PVC 50'
 (material) (depth)
2" if telescope see back.
 (size)
 - (5) screen 5' 50'
 (length) (depth to top)
2" PVC .008
 (size) (material)
 - (6) pump 1/2 5
 (HP) (yield gpm)
110 AC
 (type power)
 - (7) electric log No
 (yes or no)
 (organization running log)
 - (8) how well bottom plugged


CODED

FEB 19 1974
 BOARD OF WATER COMMISSIONERS

DRILLERS REMARKS:

If well telescopes please sketch and show depths.

GROUND LEVEL

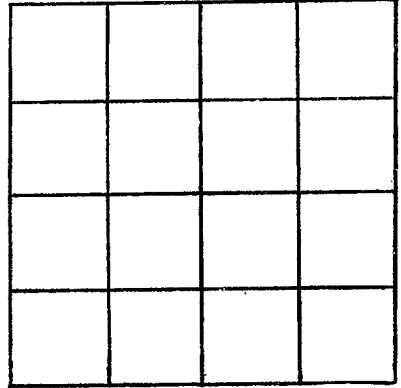

SECTION _____

Please indicate well location X.

ADDITIONAL INFORMATION

If more than one screen, show locations of each on sketch.