

MISSISSIPPI  
BOARD OF WATER COMMISSIONERS  
416 North State Street  
Jackson, Mississippi 39201

WATER WELL DRILLERS LOG **CODED**

WAYNE  
J93  
1-29-74

Jan 29 1974 Porter Drilling & Log Wayne  
date well completed firm name county well located

LANDOWNER: <u>Thomas Wilson</u>	description of formations encountered	from	to
<u>Pt 4 Hargrave-Miss</u> (mailing address)	<u>red clay</u>	<u>0</u>	<u>19</u>
	<u>sand &amp;</u>	<u>19</u>	<u>61</u>
	<u>claystone chalk</u>		
	<u>  </u>		

WELL LOCATION:  
sec 29 T 9N R 6E  
S (W)

3 miles W of Hargrave  
(distance) (direction) (nearest town)

WELL PURPOSE: Home  
(home, irrigation, municipal, industrial)

WELL COMPLETION DATA:

(1) diameter (inches) 2"

(2) total depth (feet) 61

(3) static water level (feet) 39 (below/above top of ground)

(4) casing P.V.C., 56'  
(material) (depth)

2" if telescope see back.  
(size)

(5) screen 5', 56  
(length) (depth to top)

2", galv P.V.C.  
(size) (material)

(6) pump 1, 10  
(HP) (yield gpm)

elec.  
(type power)

(7) electric log no  
(yes or no)

(organization running log)

(8) how well bottom plugged  
at rock base

DRILLERS REMARKS:


description of formations encountered	from	to
<u>red clay</u>	<u>0</u>	<u>19</u>
<u>sand &amp;</u>	<u>19</u>	<u>61</u>
<u>claystone chalk</u>		
<u>  </u>		
<u>53' 1" P.V.C. casing</u>	<u>0.11'</u>	

**CODED**

RECORDED  
INDEXED  
MAR 11 1974

If well telescopes please sketch and show depths.

GROUND LEVEL

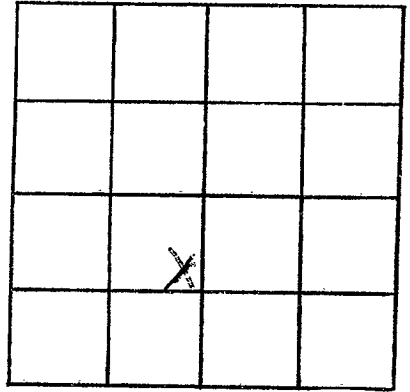

SECTION 29

Please indicate well location X.

ADDITIONAL INFORMATION

If more than one screen,  
show locations of each on sketch.