

WAYNE
J94
3-9-73

MISSISSIPPI
 BOARD OF WATER COMMISSIONERS
 416 North State Street
 Jackson, Mississippi 39201

CODED

WATER WELL DRILLERS LOG

MARCH 9, 1973 McILWAIN WATER WELL SERVICE **WAYNE**
 date well completed: RT. 2, BOX 37 county well located

LANDOWNER:
Billy Holcomb
 RT 2 WAYNESBORO, Miss
 (mailing address)

WAYNESBORO, MISS. 39367

description of formations encountered	from	to
RED CLAY	0	5
RED SAND	5	20
CLAY	20	23
WHITE SAND	23	43

WELL LOCATION:
 sec. 31 T. 9 N R. 6 E
 S W
2 miles NE of W'BORO
 (distance) (direction) (nearest town)

WELL PURPOSE: HOME
 (home, irrigation, municipal, industrial)

- WELL COMPLETION DATA:
- (1) diameter (inches) 2"
 - (2) total depth (feet) 43
 - (3) static water level (feet) 25 below
top of ground. above
 - (4) casing Galv. 38'
(material) (depth)
2"
(size) if telescope see back.
 - (5) screen 5' 38'
(length) (depth to top)
2" PVC 1008
(size) (material)
 - (6) pump 1/2 Rod 6
(HP) (yield gpm)
110 AC
(type power)
 - (7) electric log NO
(yes or no)
- (organization running log)
- (8) how well bottom plugged

CODED


DRILLERS REMARKS

APR - 4 1973

DRILLERS REMARKS:

If well telescopes please sketch and show depths.

GROUND LEVEL

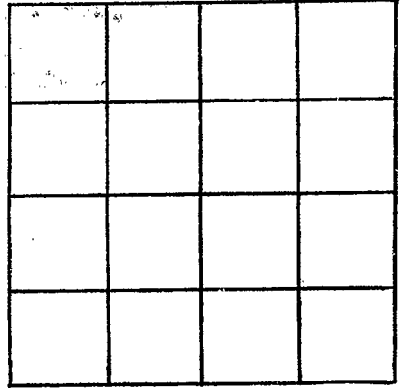

SECTION _____

Please indicate well location X.

ADDITIONAL INFORMATION

If more than one screen, show locations of each on sketch.