

WAYNE
J 95
3-13-74

MISSISSIPPI
 BOARD OF WATER COMMISSIONERS
 416 North State Street
 Jackson, Mississippi 39201

CODED

WATER WELL DRILLERS LOG

MARCH 13, 1974 19 McILWAIN WATER WELL SERVICE WAYNE
 date well completed RT. # BOX 37 county well located
WAYNESBORO, MISS. 39367

LANDOWNER:
RICHARD Tatum
Waynesboro, Miss Rt 4
 (mailing address)

description of formations encountered	from	to
<u>SAND</u>	<u>0</u>	<u>8</u>
<u>CLAY</u>	<u>8</u>	<u>12</u>
<u>RED SAND</u>	<u>12</u>	<u>18</u>
<u>MED WHITE SAND</u>	<u>18</u>	<u>25</u>
<u>COARSE SAND</u>	<u>25</u>	<u>34</u>

WELL LOCATION:
 sec 29 T 9 N R 6 E
3 miles NE of W'BORO
 (distance) (direction) (nearest town)

WELL PURPOSE: HOME
 (home, irrigation, municipal, industrial)

WELL COMPLETION DATA:

(1) diameter (inches) 2"

(2) total depth (feet) 34'

(3) static water level (feet) 10' below top of ground.

(4) casing PVC 29'
 (material) (depth)
2"
 (size) if telescope see back.

(5) screen 5' 29'
 (length) (depth to top)
2" PVC .008
 (size) (material)


(6) pump 1 1R
 (HP) (yield gpm)
110 AC
 (type power)

(7) electric log NO
 (yes or no)

(organization running log)

(8) how well bottom plugged

CODED

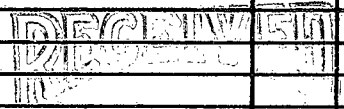


APR 4 1974

DRILLERS REMARKS:

If well telescopes please
sketch and show depths.

GROUND LEVEL

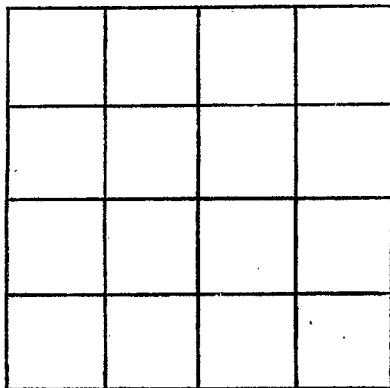

SECTION _____

Please indicate well location X.

ADDITIONAL INFORMATION

If more than one screen,
show locations of each on sketch.