

WAYNE

J 96

11-22-74

73

MISSISSIPPI  
 BOARD OF WATER COMMISSIONERS  
 416 North State Street  
 Jackson, Mississippi 39201

CODED

WATER WELL DRILLERS LOG

Nov 19 74 Raymond Water Wells Wayne  
 date well completed firm name county well located

LANDOWNER: James Nickles

description of formations encountered

from to

Rf 1

sand

0 3

Bucatons

clay

3 15

(mailing address)

sand

15 60

WELL LOCATION:

clay

60 120

sec. 15 T 7 N R 6 E

8 miles E of Clara  
(distance) (direction) (nearest town)

WELL PURPOSE: home  
(home, irrigation, municipal, industrial)

WELL COMPLETION DATA:

(1) diameter (inches) 2

(2) total depth (feet) 145

(3) static water level (feet) 90 below above top of ground.

(4) casing galv 140  
(material) (depth)

(size) if telescope see back.

(5) screen 5 140  
(length) (depth to top)

1/4 St Steel  
(size) (material)

(6) pump 1 8  
(HP) (yield gpm)

Rea  
(type power)

(7) electric log NO  
(yes or no)

(organization running log)

(8) how well bottom plugged washed

DRILLERS REMARKS:


CODED

APR 24 1974

MISS. Bd. OF WATER COMMISSIONERS

If well telescopes please sketch and show depths.

GROUND LEVEL

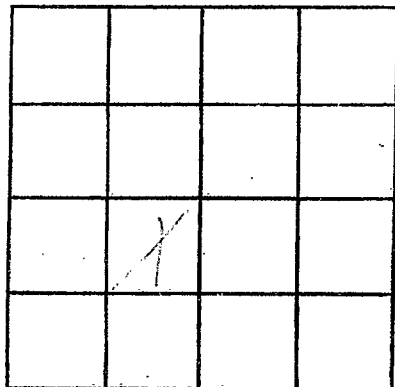

SECTION 15

Please indicate well location X.

ADDITIONAL INFORMATION

If more than one screen,  
show locations of each on sketch.