

WAYNE
J98
7-7-74

MISSISSIPPI
BOARD OF WATER COMMISSIONERS
416 North State Street
Jackson, Mississippi 39201

CODED.

WATER WELL DRILLERS LOG

July 7 1974 Bob Drilling Wayne
Date well completed firm name county well located

LANDOWNER: Johnny Lee

description of formations encountered from to

R. L. Kelley

red clay sand 0 18
chalk & sand 18 50
blue chalk 50 55

214 Wagnersboro
(mailing address)

WELL LOCATION:

sec. 9 T. 90 N. R. 6 E. W.
7 miles N of Waynes
(distance) (direction) (nearest town)

rock 55 56
blue chalk 56 63
rock 63 66
blue chalk 66 82
Mickelberry rock 82 125

WELL PURPOSE: Domestic
(home, irrigation, municipal, industrial)

red to chalk & rock 125 145
blue chalk 145 262
rock stratum 262 268

WELL COMPLETION DATA:

- (1) diameter (inches) 2"
- (2) total depth (feet) 507'
- (3) static water level (feet) 90' ^{below} _{above} top of ground.
- (4) casing steel 4.85'
(material) (depth)
2' if telescope see back.
(size)
- (5) screen 18' 4-8.9'
(length) (depth to top)
1/2" 80 ga. S.S.
(size) (material)
- (6) pump 1 rod 3
(HP) (yield gpm)
elec.
(type power)
- (7) electric log no
(yes or no)


blue chalk 268 325
rock stratum 325 344
Crown Sand 344 347
rock 347 348
Crown Sand 348 351
rock stratum 351 370
blue chalk 370 438
chalk & sand 438 445
Chalk 445 475
chalk & sand 475 484
trap sand & steel rock filled 484 507

(organization running log)

(8) how well bottom plugged flush

DRILLERS REMARKS: Drilled on red clay
84' red 154' 4"
ch. 2' at 14'
ch. Mickelberry clay

18' 80 ga. S.S. with
5' 1" pop. that in
will packer
cylindrical at 270'

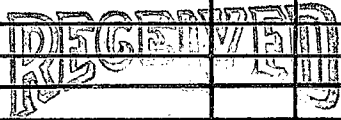

SEP 11 1974

If well telescopes please sketch and show depths.

GROUND LEVEL

X			

SECTION 9

Please indicate well location X.

ADDITIONAL INFORMATION

If more than one screen,
show locations of each on sketch.