

MISSISSIPPI
BOARD OF WATER COMMISSIONERS
416 North State Street
Jackson, Mississippi 39201

CODED

WATER WELL DRILLERS LOG

WAYNE

J99

7-1-74

July 1

1974 Porter Drilling & Pump

Wayne

Date well completed

firm name

county well located

LANDOWNER: Jessie Jordan

description of formations encountered

from

to

Box 4 Waynesboro Miss
(mailing address)

red clay	0	40
red sandstone	40	75
med white sand	75	80
chalk & sand	80	84
stopped on chalk		

WELL LOCATION:

sec. 5 T 9 (N) R. 6 E (W)
8 miles N of Waynesboro
(distance) (direction) (nearest town)

WELL PURPOSE: home
(home, irrigation, municipal, industrial)

WELL COMPLETION DATA:

- (1) diameter (inches) 2"
- (2) total depth (feet) 80'
- (3) static water level (feet) 42' ^{below} _{above} top of ground.
- (4) casing steel 76'
(material) (depth)
- 2 if telescope see back.
(size)
- (5) screen 4' 76'
(length) (depth to top)
- 1 1/4" 6 slot S.S.
(size) (material)
- (6) pump 1 10
(HP) (yield gpm)
- elec.
(type power)
- (7) electric log no
(yes or no)

4' 1 1/4" 6 slot SS
screwed on end of case
63' 1 1/4" drop pipe

(organization running log)

(8) how well bottom plugged
flush point

DRILLERS REMARKS:


RECEIVED

SEP 11 1974

MISS. BD. OF WATER COMMISSIONERS

If well telescopes please sketch and show depths.

GROUND LEVEL

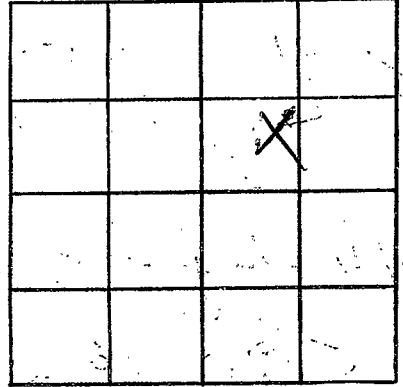

SECTION 5

Please indicate well location X.

ADDITIONAL INFORMATION

If more than one screen, show locations of each on sketch.