

WAYNE
J 101
2-21-75

MISSISSIPPI
BOARD OF WATER COMMISSIONERS
 416 North State Street
 Jackson, Mississippi 39201

WATER WELL DRILLERS LOG

CODED

FEB 21, 75 19 **McILWAIN WATER WELL SERVICE** **WAYNE**
 date well completed R1. firm name county well located
WAYNESBORO MISS 39367


LANDOWNER:	description of formations encountered	from	to
EDD BLAKENEY Box 4 Waynesboro, Miss. (mailing address)			
WELL LOCATION: sec. 9 T. 9 N. R. 6 6 miles N of Waynesboro (distance) (direction) (nearest town)	Red Sand	10	22
WELL PURPOSE: Home (home, irrigation, municipal, industrial)	clay	22	41
WELL COMPLETION DATA:	Sand	41	51
(1) diameter (inches) 2"			
(2) total depth (feet) 51'			
(3) static water level (feet) 46' below top of ground.			
(4) casing PVC , 46' (material) (depth) 2" (size) if telescope see back.			
(5) screen 5' , 46' (length) (depth to top) 2" , PVC .008 (size) (material)			
(6) pump 1 , 8 (HP) (yield gpm) 220 AC (type power)			
(7) electric log no (yes or no) (organization running log)			
(8) how well bottom plugged			
DRILLERS REMARKS:			

CODED

RECEIVED
MAR 5 1975
MISS. Bd. OF WATER COMMISSIONERS

If well telescopes please sketch and show depths.

GROUND LEVEL

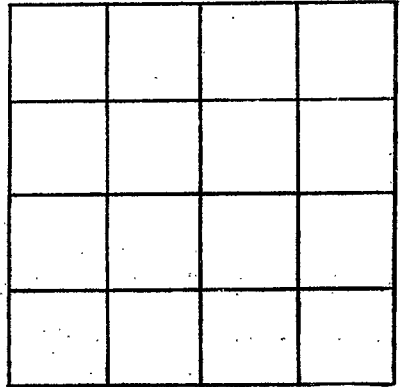

SECTION _____

Please indicate well location X.

ADDITIONAL INFORMATION

If more than one screen, show locations of each on sketch.