

CODED

WAYNE
J 103
8-16-75

MISSISSIPPI
BOARD OF WATER COMMISSIONERS
416 North State Street
13P Jackson, Mississippi 39201

WATER WELL DRILLERS LOG

McILWAIN WATER WELL SERVICE

AUG 16, 1975
date well completed

RT. 2 BOX 37

Waynesboro, MISS. 39367

WAYNE

county well located


LANDOWNER:	description of formations encountered	from	to
MR JIMMIE BOYKIN	RED CLAY	0	8
Rt 4 Waynesboro, Miss. (mailing address)	RED SAND	8	20
WELL LOCATION: sec. 32 T 9 N R 6 E 2 miles NE of W BORO (distance) (direction) (nearest town)	SAND, SOME CLAY	20	40
	SANDY CLAY	40	55
WELL PURPOSE: HOME (home, irrigation, municipal, industrial)	COARSE SAND	55	67
WELL COMPLETION DATA:			
(1) diameter (inches) 2"			
(2) total depth (feet) 67			
(3) static water level (feet) 35' below top of ground.			
(4) casing PVC 62' (material) (depth) 2" if telescope see back. (size)			
(5) screen 5' 62' (length) (depth to top) 2" PVC .008 (size) (material)			
(6) pump 1 10 (HP) (yield gpm) 220 AC (type power)			
(7) electric log NO (yes or no)			
(organization running log)			
(8) how well bottom plugged			
DRILLERS REMARKS:			

MISS. Bd. of Water Comm

AUG 16 1975

If well telescopes please sketch and show depths.

GROUND LEVEL

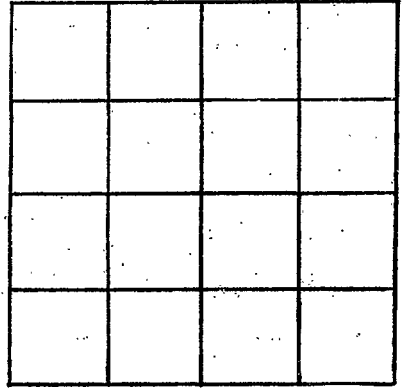

SECTION _____

Please indicate well location X.

ADDITIONAL INFORMATION

If more than one screen, show locations of each on sketch.