

COUED

Wayne
J 104
8-25-75

**MISSISSIPPI
BOARD OF WATER COMMISSIONERS**
416 North State Street
Jackson, Mississippi 39201

WATER WELL DRILLERS LOG

McILWAIN WATER WELL SERVICE

Wayne

Aug 25, 1975 19
date well completed

RT. from name Box 37

county well located

WAYNESBORO MISS 39367

LANDOWNER:

Mr Tommy Boykin
Rt 4 Waynesboro, Miss.
(mailing address)

**description of formations
encountered**

from

to

Red Clay

0 8

Mixed Clay

8 14

Sand

14 50

Sand & Clay

50 72

Sand

72 78

WELL LOCATION:

sec. 32 T 9 N R 6 E 13 E
2 miles NE of W'BORO
(distance) (direction) (nearest town)

WELL PURPOSE: HOME

(home, irrigation, municipal, industrial)


WELL COMPLETION DATA:

- (1) diameter (inches) 2"
- (2) total depth (feet) 78'
- (3) static water level (feet) 44' below above top of ground.
- (4) casing PVC 73'
(material) (depth)
2"
(size) If telescope see back.
- (5) screen 5' 73'
(length) (depth to top)
2" PVC .008
(size) (material)
- (6) pump 1 8
(HP) (yield gpm)
220 AC
(type power)
- (7) electric log NO
(yes or no)

(organization running log)

(8) how well bottom plugged _____

DRILLERS REMARKS:

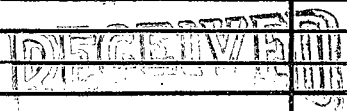

SEP 15 1975

If well telescopes please sketch and show depths.

GROUND LEVEL

| | | | |
|--|--|--|--|
| | | | |
| | | | |
| | | | |
| | | | |

SECTION _____

Please indicate well location X.

ADDITIONAL INFORMATION

If more than one screen, show locations of each on sketch.