

Wayne  
 J 105  
 8-30-75

MISSISSIPPI  
 BOARD OF WATER COMMISSIONERS  
 416 North State Street  
 Jackson, Mississippi 39201

CODED

WATER WELL DRILLERS LOG

Aug 30, 1975  
 date well completed

McILWAIN WATER WELL SERVICE

Wayne

RT. 4 BOX 37  
 WAYNESBORO MISS 39267

county well located


LANDOWNER:	description of formations encountered	from	to
MR T. G. CONNOR	Red Clay	0	4
RT 4 WAYNESBORO Miss (mailing address)	White + Yellow Clay	4	8
WELL LOCATION: sec. 32 T 9 N R 6 E 13 P 2 miles NE of W'BORO (distance) (direction) (nearest town)	Sand	8	45
WELL PURPOSE: (home, irrigation, municipal, industrial)	Sand + some Clay	45	55
WELL COMPLETION DATA:	Clay	55	60
(1) diameter (inches) 2"	Sand + Clay	60	72
(2) total depth (feet) 85'	Sand	72	85
(3) static water level (feet) 47' below top of ground.			
(4) casing PVC 80' (material) (depth) 2" if telescope see back. (size)			
(5) screen 5' 80' (length) (depth to top) 2" PVC .008 (size) (material)			
(6) pump 3/4 8 (HP) (yield gpm) 220 AC (type power)			
(7) electric log NO (yes or no)  (organization running log)			
(8) how well bottom plugged			

RECEIVED  
 SEP 15 1975

DRILLERS REMARKS:

If well telescopes please sketch and show depths.

GROUND LEVEL

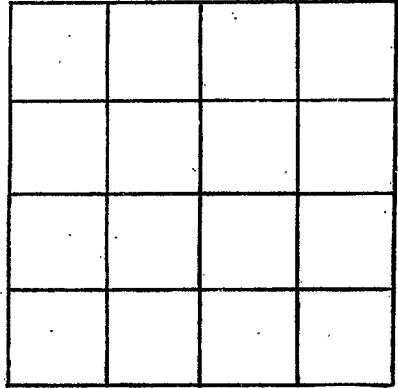

SECTION \_\_\_\_\_

Please indicate well location X.

ADDITIONAL INFORMATION

A series of horizontal lines for providing additional information, starting below the 'ADDITIONAL INFORMATION' header and extending to the bottom of the page.

If more than one screen, show locations of each on sketch.