

CODED

Wayne
J 106
8-19-75

MISSISSIPPI
BOARD OF WATER COMMISSIONERS
416 North State Street
Jackson, Mississippi 39201

WATER WELL DRILLERS LOG
McILWAIN WATER WELL SERVICE

AUG 19, 1975 19 RT. 2, BOX 37 WAYNE
date well completed WAYNESBORO, MISS. 39367 county well located

LANDOWNER:
RODGER McNEESE
RT 2 W' BORO, Miss.
(mailing address)


description of formations encountered	from	to
RED SANDY CLAY	0	8
RED SAND	8	13
CLAY	13	17
COARSE WHITE SAND	17	65
YELLOW CLAY	65	80
BLUE CLAY	80	113
Rock + Limy Clay	113	148
BROWN CLAY	148	166
HONEY COMB ROCK	166	195

WELL LOCATION:
sec. 29 T 9 N R 6 W 13 P
3 miles NE of W' BORO
(distance) (direction) (nearest town)

WELL PURPOSE: HOME
(home, irrigation, municipal, industrial)


- WELL COMPLETION DATA:
- (1) diameter (inches) 2"
 - (2) total depth (feet) 195'
 - (3) static water level (feet) 138' below top of ground.
 - (4) casing PVC, 166' (material) (depth)
2" (size) if telescope see back.
 - (5) screen NONE (length) (depth to top)
 - (6) pump 2 (HP) 4.5 (yield gpm)
220 AC (type power)
 - (7) electric log No (yes or no)
 - (8) how well bottom plugged

DRILLERS REMARKS:

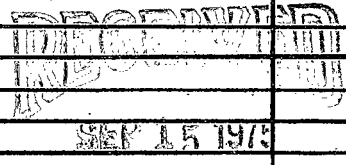

If well telescopes please sketch and show depths.

GROUND LEVEL

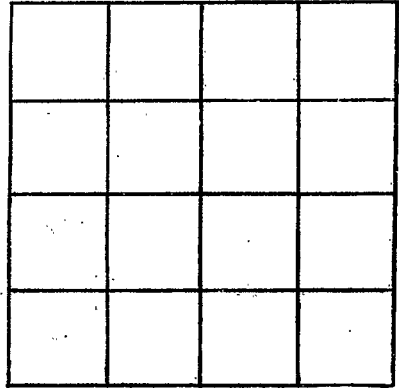

SECTION _____

Please indicate well location X.

ADDITIONAL INFORMATION

If more than one screen, show locations of each on sketch.