

Wayne
 J 108
 9-17-75

MISSISSIPPI
 BOARD OF WATER COMMISSIONERS
 416 North State Street
 Jackson, Mississippi 39201

CODED

WATER WELL DRILLERS LOG


Sept 17, 75 ^{13P} McILWAIN WATER WELL SERVICE Wayne
 date well completed RT. firm name county well located
 WAYNESBORO MISS 39367

LANDOWNER:	description of formations encountered	from	to
JOHNCE ROBINSON RT 2 WAYNESBORO, Miss. (mailing address)			
	Red Sand	10	30
WELL LOCATION: sec. 26 T 9 N R 6 W 6 miles NE of Waynesboro (distance) (direction) (nearest town)	Yellow Sand, some clay Sand	30	40
WELL PURPOSE: HOME (home, irrigation, municipal, industrial)		40	56
WELL COMPLETION DATA:			
(1) diameter (inches) 2"			
(2) total depth (feet) 56			
(3) static water level (feet) 44' below top of ground			
(4) casing PVC 51' (material) (depth) 2" (size) If telescope see back.			
(5) screen 5' 51' (length) (depth to top) 2" PVC (size) (material)			
(6) pump 3/4 HP 7 (yield gpm) 220 AC (type power)			
(7) electric log no (yes or no)			
(organization running log)			
(8) how well bottom plugged			
DRILLERS REMARKS:			

MISS. BOARD OF WATER COMMISSIONERS
 OCT 22 1975

If well telescopes please sketch and show depths.

GROUND LEVEL

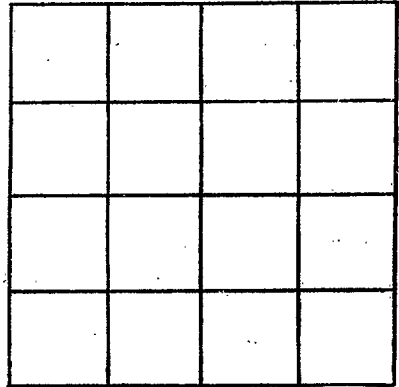

SECTION _____

Please indicate well location X.

ADDITIONAL INFORMATION

If more than one screen, show locations of each on sketch.