

Wayne  
 J 10'9  
 9-18-75

MISSISSIPPI  
 BOARD OF WATER COMMISSIONERS  
 416 North State Street  
 Jackson, Mississippi 39201

WATER WELL DRILLERS LOG

Sept 18, 75 1975 date well completed  
 McILWAIN WATER WELL SERVICE WAYNE  
 RT. 2 BOX 37 WAYNESBORO, MISS. 39367  
 county well located

LANDOWNER:  
 MR. Bill BANKSTON  
 Rt 2 Waynesboro, Miss  
 (mailing address)

description of formations encountered	from	to
Red Sandy Clay	0	10
White Sand	10	25
Sand, some clay	25	45
Coarse Sand	45	58

WELL LOCATION:  
 sec. 29 T 9 N R 6 E  
 3 miles NE of W'BORO  
 (distance) (direction) (nearest town)

WELL PURPOSE: HOME  
 (home, irrigation, municipal, industrial)

WELL COMPLETION DATA:

(1) diameter (inches) 2"

(2) total depth (feet) 58'

(3) static water level (feet) 40' below top of ground.

(4) casing PVC 53' (material) (depth)  
 2" (size) if telescope see back.

(5) screen 5' 53' (length) (depth to top)  
 2" PVC (size) (material)

(6) pump 1 HP 11 (yield gpm)  
 220 AC (type power)

(7) electric log NO (yes or no)

(organization running log)


(8) how well bottom plugged

DRILLERS REMARKS:

INDEXED  
 OCT 29 1975

If well telescopes please sketch and show depths.

GROUND LEVEL

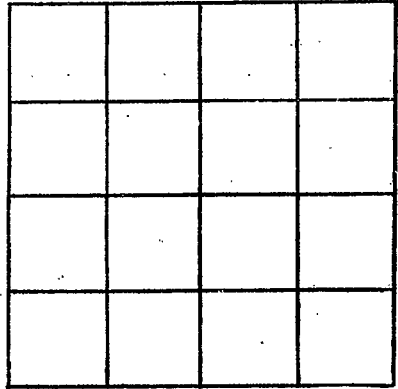

SECTION \_\_\_\_\_

Please indicate well location X.

ADDITIONAL INFORMATION

If more than one screen, show locations of each on sketch.