

WAYNE
J III
4-21-75

MISSISSIPPI
 BOARD OF WATER COMMISSIONERS **CODED**
 416 North State Street
 Jackson, Mississippi 39201

WATER WELL DRILLERS LOG


April 21, 1975 19 McILWAIN WATER WELL SERVICE Wayne
 date well completed RT firm, name BOX 37 county well located
 WAYNESBORO, MISS. 39367

LANDOWNER:	description of formations encountered	from	to
Melvin Walker Rt 2 Waynesboro, Miss (mailing address)			
WELL LOCATION: sec. <u>32</u> T <u>9</u> N R <u>6</u> E <u>2</u> miles <u>NE</u> of <u>W'BORO</u> (distance) (direction) (nearest town)	Red sand	5	15
WELL PURPOSE: <u>HOME</u> (home, irrigation, municipal, industrial)	Sand + clay	15	35
WELL COMPLETION DATA: (1) diameter (inches) <u>2"</u> (2) total depth (feet) <u>45'</u> (3) static water level (feet) <u>25'</u> below above top of ground. (4) casing <u>PVC</u> <u>40'</u> (material) (depth) <u>2"</u> if telescope see back. (size) (5) screen <u>5'</u> <u>40'</u> (length) (depth to top) <u>2"</u> <u>PVC .008</u> (size) (material) (6) pump <u>1</u> <u>10</u> (HP) (yield gpm) <u>220 AC</u> (type power) (7) electric log <u>NO</u> (yes or no) (organization running log) (8) how well bottom plugged	Sand	35	45
DRILLERS REMARKS:			

RECEIVED
MAY 14 1975
 MISS. BD. OF WATER COMMISSIONERS

If well telescopes please sketch and show depths.

GROUND LEVEL

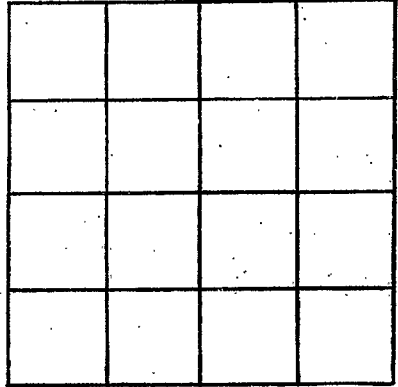

SECTION _____

Please indicate well location X.

ADDITIONAL INFORMATION

If more than one screen, show locations of each on sketch.